

KANSAS

Form 26 200 Bks. 5-41 McW. Douglas

Map No. 11 Sec. 3 Twp. 14 R. 21EWell No. 1 StanleyReinholdt & Edwards Company

FIRST REPORT

and.

Contractor

COMPLETED

NW NE NW


330 Ft. from N. Line

Ft. from S. Line

990 Ft. from E. Line

Ft. from W. Line

SECTION PLAT

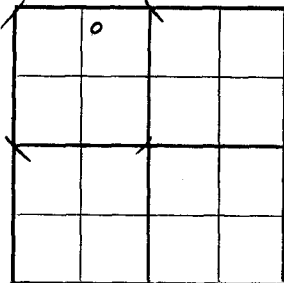

Location

Rig up

Drilling and Remarks:

arb 1716-19705" 1906Granite 2463-70J & A

RECORD

Cased in. ft.

Sand

Gas

Oil

Total Depth 2503

PRODUCTION

1st 24 hrs. Nat.

1st 24 hrs. after shot

Gas Cu. Ft.

Dry Hole

Abandoned

Date

AUG 13 1941 19

S. J. LEWIS Scout

FORM 252-A 5M 6-41 PETROL

KANSAS


Douglas

Sec. 3 Twp. 14 R. 21-EWell No. #1 Stanley FarmReinholdt & Edwards Company330 Ft. from N. Line

Ft. from S. Line

990 Ft. from E. Line

Ft. from W. Line

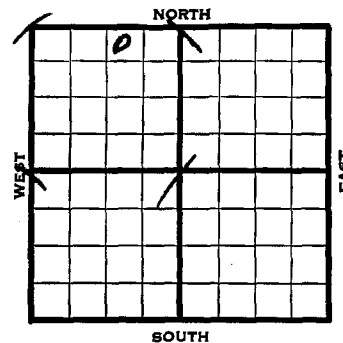

1941

REPORT

8/13

Arb. 1716-1970'

5" - 1906'

T.D. 2503'

Granite 2463-70'

FIRST REPORT

and
ABANDONED

KANSAS


FORM 51 5M 4-41 PETROL

Douglas

Section 3 Township 14 Range 21-E

Well No. 1 Stanley

Company Reinholdt & Edwards

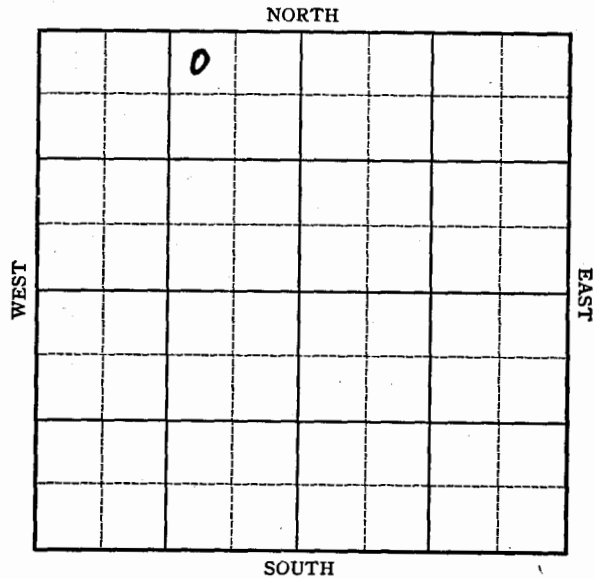

7L 2503'