

Douglas

Map No. KANSAS Sec. 33 Twp. 14 R. 21 E

Well No. 1 Elder

Steinbuechel et al Company

Contractor

Douglas

Map No. KANSAS Sec. 33 Twp. 14 R. 21 E

Well No. 1 Elder

Steinbuechel et al Company

Contractor

FIRST REPORTS

SECTION PLAT

1120 Ft. from N. Line
Ft. from S. Line
1120 Ft. from E. Line
Ft. from W. Line

Section plat grid with '0' in the top-left cell.

COMPLETE

SECTION PLAT

1120 Ft. from N. Line
Ft. from S. Line
1120 Ft. from E. Line
Ft. from W. Line

Section plat grid with '0' in the top-left cell.

ABANDONED

Location

RECORD

Rig up

Drilling and Remarks:

Rigging up

Cased in. ft.
Sand
Gas
Oil
Total Depth

PRODUCTION

1st 24 hrs. Nat.
1st 24 hrs. after shot
Gas Cu. Ft.
Dry Hole
Abandoned

Location

RECORD

Rig up

Drilling and Remarks:

Cased in. ft.
Sand
Gas
Oil
Total Depth 1000

PRODUCTION

1st 24 hrs. Nat.
1st 24 hrs. after shot
Gas Cu. Ft.
Dry Hole
Abandoned

Date

JAN 15 1930

CHAS. L. SHERWOOD

192 Scout

Date


NOV 19 1930

CHAS. L. SHERWOOD

192 Scout

*Douglas*  
Map No. KANSAS Sec. 33 Twp. 14 R. 21<sup>E</sup>  
Well No. 1- Elder Farm  
Steinbuechel et al Company

1120 Ft. from N. Line  
\_\_\_\_\_ Ft. from S. Line  
1120 Ft. from E. Line  
\_\_\_\_\_ Ft. from W. Line

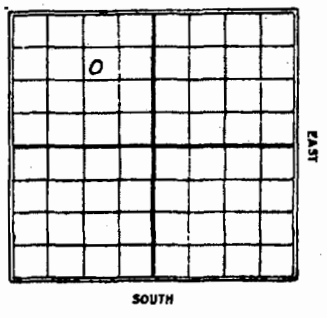

1930

Date	REPORT
1/15	<i>Ryning up</i>
1/22	—
1/29	—
2/4	<i>Diplog. 200</i>
2/11	—
2/19	<i>Diplog 400'</i>
2/26	—
3/5	<i>Log. 625'</i>
3/12	<i>Diplog. 750'</i>
3/19	<i>Sand 766-90 Slot 30 etc, show oil</i>
3/26	<i>S.D. 880'</i>
4/2	—
4/9	—
4/16	—
4/23	—
4/30	—
5/7	<i>U.I.R. 6"-1000'</i>
5/14	— 6/11 — 7/9 —
5/21	— 6/18 — 7/16 —
5/28	— 6/25 — 7/23 —
6/4	— 7/2 — 8/16 —

7/30- U.I.R. 6"-1000'  
 8/6 —  
 8/13 —  
 8/20 —  
 8/27- S.D. 1000'  
 9/3 —  
 9/10 —  
 9/17 —  
 9/24 —  
 10/11 —  
 10/18 —  
 10/15 —  
 10/22 —  
 10/29 —  
 11/5 —  
 11/12 —  
 11/19- T.P. 1000'  
*Dry & Abandon*

