

FEB 17 1984

1-14-21E end

TYPE

AFFIDAVIT OF COMPLETION FORM

ACO-1 WELL HISTORY

Compt. \_\_\_\_\_

SIDE ONE State Geological Survey

(Rules 82-3-130 and 82-3-107)

DOCKET NO. NP \_\_\_\_\_

This form shall be filed with the Kansas Corporation Commission, 200 Colorado Derby Building, Wichita, Kansas 67202, within ninety (90) days after the completion of a well, regardless of how the well was completed.

FOR INFORMATION REGARDING THE NUMBER OF COPIES TO BE FILED AND APPLICATIONS REQUIRING COPIES OF ACO-1 FORMS SEE PAGE TWO (2), SIDE TWO (2) OF THIS FORM.

F \_\_\_\_\_ Letter requesting confidentiality attached.

C  Attach ONE COPY of EACH wireline log run (i.e. electrical log, sonic log, gamma ray neutron log etc.)\*\*\*Check here if NO logs were run \_\_\_\_\_.

PLEASE FILL IN ALL INFORMATION. IF NOT AVAILABLE, INDICATE. IF INFORMATION LATER BECOMES AVAILABLE, SUBMIT BY LETTER.

LICENSE # 8653 EXPIRATION DATE 7-10-84

OPERATOR Petroleum Technologies, Inc. API NO. 15-091-21,186

ADDRESS 4005 E. Kellogg COUNTY Johnson

Wichita, Ks. 67218 FIELD \_\_\_\_\_

\*\* CONTACT PERSON N. D. Urquhart PROD. FORMATION N/A

PHONE 316-687-9963 Indicate if new pay.

PURCHASER N/A LEASE Stockmyer

ADDRESS \_\_\_\_\_ WELL NO. 1-1

WELL LOCATION NE SE SE

DRILLING Central Plains Oil & Gas 1155 Ft. from S Line and

CONTRACTOR \_\_\_\_\_ 495 Ft. from E Line of

ADDRESS 824 Valerie Lane the SE (Qtr.) SEC 1 TWP 14S RGE 21

Gardner, Ks. 66030

PLUGGING Central Plains Oil & Gas

CONTRACTOR \_\_\_\_\_

ADDRESS 824 Valerie Lane

Gardner, ks. 66030

TOTAL DEPTH 1040' PBD 0

SPUD DATE 1-18-84 DATE COMPLETED 1-25-84

ELEV: GR 1040' DF \_\_\_\_\_ KB \_\_\_\_\_

DRILLED WITH (CABLE) (ROTARY) (AIR) TOOLS.

DOCKET NO. OF DISPOSAL OR REPRESSURING WELL BEING USED TO DISPOSE OF WATER FROM THIS LEASE \_\_\_\_\_

Amount of surface pipe set and cemented 40' DV Tool Used? \_\_\_\_\_


TYPE OF COMPLETION THIS AFFIDAVIT APPLIES TO: (Circle ONE) - Oil, Shut-in Gas, Gas, Dry Disposal, Injection, Temporarily Abandoned. If OWWO, indicate type of re-completion \_\_\_\_\_ Other completion \_\_\_\_\_ NGPA filing \_\_\_\_\_

ALL REQUIREMENTS OF THE STATUTES, RULES AND REGULATIONS PROMULGATED TO REGULATE THE OIL AND GAS INDUSTRY HAVE BEEN FULLY COMPLIED WITH.

A F F I D A V I T

N. D. Urquhart, being of lawful age, hereby certifies that:

I am the Affiant, and I am familiar with the contents of the foregoing Affidavit.

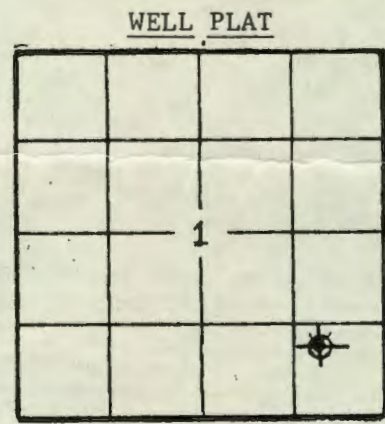

312-41-1

(E)  
(W)

Side TWO  
 OPERATOR Petroleum Technologies, Inc. LEASE NAME Stockmyer SEC 1 TWP 14 RGE 21  
 WELL NO 1-1

FILL IN WELL INFORMATION AS REQUIRED:

Show all important zones of porosity and contents thereof; cored intervals, and all drill-stem tests, including depth interval tested, cushion used, time tool open, flowing and shut-in pressures, and recoveries.

Show Geological markers, logs run, or other Descriptive information.

Formation description, contents, etc.	Top	Bottom	Name	Depth
<input checked="" type="checkbox"/> Check if no Drill Stem Tests Run. <input type="checkbox"/> Check if samples sent Geological Survey.			U. Squirrel	639
			L. Squirrel	708
			1st Cattleman	747
			2nd Cattleman	766
			3rd Cattleman	782
			U. Bartlesville	835
			L. Bartlesville	895
			Tucker	952
			Burgess	1027
			Mississippi	1036
If additional space is needed use Page 2				

Report of all strings set — surface, intermediate, production, etc. CASING RECORD (New) or (Used)

Purpose of string	Size hole drilled	Size casing set (in O.D.)	Weight lbs/ft.	Setting depth	Type cement	Sacks	Type and percent additives
Surface	2 7/8"	7"		40'			

LINER RECORD

PERFORATION RECORD

Top, ft.	Bottom, ft.	Sacks cement	Shots per ft.	Size & type	Depth interval

TUBING RECORD

Size	Setting depth	Packer set at