

STATE CORPORATION COMMISSION OF KANSAS
OIL & GAS CONSERVATION DIVISION

WELL COMPLETION OR RECOMPLETION FORM
ACO-1 WELL HISTORY

DESCRIPTION OF WELL AND LEASE

Operator: License # 8509
Name Evans Energy Development, Inc.
Address 401 S. Main, Suite 11
City/State/Zip Ottawa, KS 66067

Purchaser none

Operator Contact Person Glenn A. Evans
Phone 913.242-5733

Contractor: License # 8509
Name Evans Energy Development, Inc.

Wellsite Geologist none
Phone

Designate Type of Completion

- New Well
- Re-Entry
- Workover
- Oil
- Gas
- Dry
- SWD
- Inj
- Other (Core, Water Supply etc.)
- Temp Abd
- Delayed Comp.

If ONWO: old well info as follows:

Operator
Well Name
Comp. Date Old Total Depth

WELL HISTORY

Drilling Method:

- Mud Rotary
- Air Rotary
- Cable

.5/18/85... ..5/20/85... ..5/20/85...
Spud Date Date Reached TD Completion Date

.965... ..N/A...
Total Depth PBDT

Amount of Surface Pipe Set and Cemented at 85 feet
Multiple Stage Cementing Collar Used? Yes No
If yes, show depth set... feet
If alternate 2 completion, cement circulated from 85 feet depth to surface 28 SX cmt

API NO. 15-091-21,529
County Johnson
SE SE SE Sec. 35 Twp. 14 Rge. 21 East West

640 Ft North from Southeast Corner of Section
200 Ft West from Southeast Corner of Section
(Note: Locate well in section plat below)


Lease Name Geirenger Well # 1

Field Name

Producing Formation none

Elevation: Ground unknown KB

Section Plat

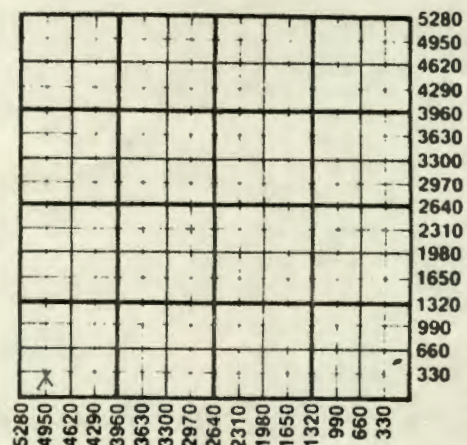

WATER SUPPLY INFORMATION

Disposition of Produced Water: N/A Disposal Repressuring
Docket #

Questions on this portion of the ACO-1 call:

Water Resources Board (913) 296-3717

Source of Water: N/A

Division of Water Resources Permit #

Groundwater...Ft North from Southeast Corner (Well) ...Ft West from Southeast Corner of Sec Twp Rge East West

Surface Water...Ft North from Southeast Corner (Stream, pond etc)...Ft West from Southeast Corner Sec Twp Rge East West

Other (explain) (purchased from city, R.W.D. #)

INSTRUCTIONS: This form shall be completed in duplicate and filed with the Kansas Corporation Commission, 200 Colorado Derby Building, Wichita, Kansas 67202, within 90 days after completion or recompletion of any well. Rule 82-3-130 and 82-3-107 apply.

Information on side two of this form will be held confidential for a period of 12 months if requested in writing and submitted with the form. See rule 82-3-107 for confidentiality in excess of 12 months. One copy of all wireline logs and drillers time log shall be attached with this form. Submit CP-4 form with all plugged wells. Submit CP-111 form with all temporarily abandoned wells.

All requirements of the statutes, rules and regulations promulgated to regulate the oil and gas industry have been fully complied with.