

STATE CORPORATION COMMISSION OF KANSAS
OIL & GAS CONSERVATION DIVISIONL COMPLETION OR RECOMPLETION FORM
ACO-1 WELL HISTORY

DESCRIPTION OF WELL AND LEASE

Operator: license # 9233
 name MIDLAND ENTERPRISES
 address 935 SUNSET DR.
 City/State/Zip LAWRENCE, KS 66044

Operator Contact Person JOE GARRETT
 Phone (913) 841-6219

Contractor: license # 6807
 name OIL DRILLERS & DEVELOPERS

Wellsite Geologist JOE GARRETT
 Phone (913) 841-6219

Designate Type of Completion

☒ New Well ☐ Re-Entry ☐ Workover

☐ Oil ☐ SWD ☐ Temp Abd
☐ Gas ☐ Inj ☐ Delayed Comp.
☒ Dry ☐ Other (Core, Water Supply etc.)

OWWO: old well info as follows:

Operator
 Well Name
 Comp. Date Old Total Depth

WELL HISTORY

Drilling Method: ☒ Mud Rotary ☐ Air Rotary ☐ Cable

12/7/85 .. 12/10/85 .. 12/22/85
 Mud Date Date Reached TD Completion Date

834'
 Total Depth PBT

Amount of Surface Pipe Set and Cemented at 40 feet

Multiple Stage Cementing Collar Used? ☐ Yes ☒ No

If Yes, Show Depth Set feet

Alternate 2 completion, cement circulated
 from feet depth to w/ SX cmt

API NO. 15 - 045 20918

County Douglas

SE. SE. NW Sec. 18 Twp. 14 Rge. 24 ☒ East
 (Location) ☐ West

2940 Ft North from Southeast Corner of Section
3080 Ft West from Southeast Corner of Section
 (Note: locate well in section plat below)


Lease Name BRADLEY Well# 2-85

Field Name UNKNOWN

Producing Formation NONE

Elevation: Ground 900 KB 904

Section Plat

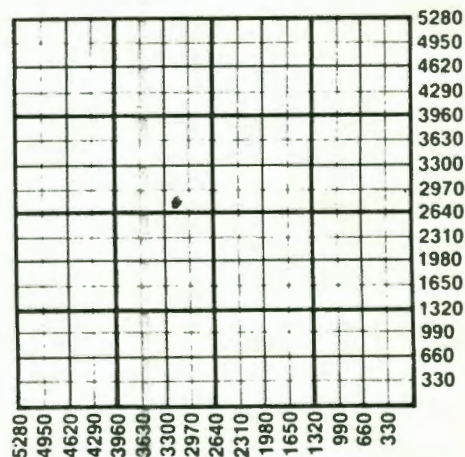

WATER SUPPLY INFORMATION

Source of Water:

Division of Water Resources Permit #

☐ Groundwater Ft North From Southeast Corner and
 (Well) Ft. West From Southeast Corner of
 Sec Twp Rge ☐ East ☐ West

☐ Surface Water Ft North From Southeast Corner and
 (Stream, Pond etc.) Ft West From Southeast Corner
 Sec Twp Rge ☐ East ☐ West

☐ Other (explain)
 (purchased from city, R.W.D.#)

Disposition of Produced Water: ☐ Disposal
☐ Repressuring

Docket #

INSTRUCTIONS: This form shall be completed in duplicate and filed with the Kansas Corporation Commission, 200 Colorado Derby Building, Wichita, Kansas 67202, within 90 days after completion or recompletion of any well. Rules 82-3-130 and 82-3-107 apply.

Information on side two of this form will be held confidential for a period of 12 months if requested in writing and submitted with the form. See rule 82-3-107 or confidentiality in excess of 12 months.

Operator Name Midland Ent. Lease Name BRADLEY Well# 285 SEC. 18 TWP. 14 RGE. 2 (....)

WELL LOG

INSTRUCTIONS: Show important tops and base of formations penetrated. Detail all cores. Report all drill stem tests giving interval tested, time tool open and closed, flowing and shut-in pressures, whether shut-in pressure reached static level, hydrostatic pressures, bottom hole temperature, fluid recovery, and flow rates if gas to surface during test. Attach extra sheet if more space is needed. Attach copy of log.

Drill Stem Tests Taken
Samples Sent to Geological Survey
Cores Taken

☐ Yes ☒ No
☐ Yes ☒ No
☐ Yes ☒ No

Formation Description
☐ Log ☒ Sample

Name

Top

Bottom

CASING RECORD

☐ new☒ used

Report all strings set - conductor, surface, intermediate, production, etc.

Purpose of string	size hole drilled	size casing set (In O.D.)	weight lbs/ft.	setting depth	type of cement	# sacks used	type and percent additives
SURFACE.....	9"	7 1/2"		40	no. 1400	5	
.....							
.....							
.....							

PERFORATION RECORD

shots per foot specify footage of each interval perforated

Acid, Fracture, Shot, Cement Squeeze Record

(amount and kind of material used)

Depth

.....			
.....			

18-14-21E

SHEET LOG

WELL NO. 2-85FARM BradleySTATE Kansas COUNTY DouglasSECTION 12 TOWNSHIP 14 RANGE 20FOR WELL OWNER Max PainterCOMMENCED SPUDING 10/23/85FINISHED DRILLING 10/26/85DRILLER'S NAME Bob JackDRILLER'S NAME Robert DanA.P.I. NO. 15-045-20896

THICKNESS OF STRATA	FORMATION	TOTAL DEPTH	THICKNESS OF STRATA	FORMATION	TOTAL DEPTH
40'	Topsoil & Clay	40'	5'	Lime	498'
106'	Shale	146'	3'	Shale	501'
10'	Lime	156'	6'	Lime Hertha	507'
2'	Shale	158'	132'	Shale	639'
20'	Lime	178'	2'	Lime	641'
6'	Shale	184'	7'	Shale	648'
8'	Lime	192'	2'	Lime	650'
6'	Shale	198'	19'	Sandy Shale	669'
22'	Lime	220'	9'	Lime	678'
	Sandy Shale	246'	3'	Shale	681'
	Lime	270'	6'	Lime	687'
57'	Shale	327'	7'	Shale	694'
8'	Lime	335'	7'	Lime	701'
4'	Shale	339'	16'	Shale	717'
17'	Lime	356'	3'	Lime	720'
20'	Shale	376'	5'	Shale	725'
8'	Lime	384'	10'	Lime	735'
20'	Shale	414'	34'	Shale	769'
11'	Lime	425'	12'	Lime	781'
7'	Shale	432'	15'	Sandy Shale	796'
28'	Lime	460'	5'	Oil Sand	801'
5'	Shale	465'	28'	Shale	829'
23'	Lime	488'	5'	Lime	834'
5'	Shale	493'	26'	Shale	860'

TD 860 feet
Cored 2 times