

Map No. NM Sec. 3 Twp. 14 R. 22E

Well No. 1 Johnson


Cowan etal Company

Contractor

FIRST REPORT

SECTION PLAT

NW NE NW
360 Ft. from N. Line
Ft. from S. Line
960 Ft. from E. Line
Ft. from W. Line

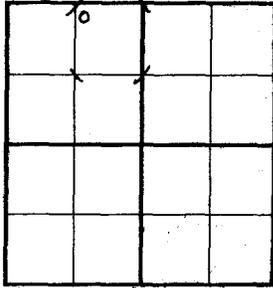

MISCELLANEOUS

Location _____

Rig up _____

Drilling and Remarks:

Dr lg. 358

Mach.

RECORD

Cased _____ in., _____ ft.

Sand _____

Gas _____

Oil _____

Total Depth _____

PRODUCTION

1st 24 hrs. Nat. _____

1st 24 hrs. after shot _____

Gas _____ Cu. Ft.

Dry Hole _____

Abandoned _____

Date

MAY 31 1939 19

S. J. LEWIS Scout

Map No. NM Sec. 3 Twp. 14 R. 22E

Well No. 1 Johnson


Cowan etal Company

Contractor

COMPLETED

SECTION PLAT

NW NE NW
360 Ft. from N. Line
Ft. from S. Line
960 Ft. from E. Line
Ft. from W. Line

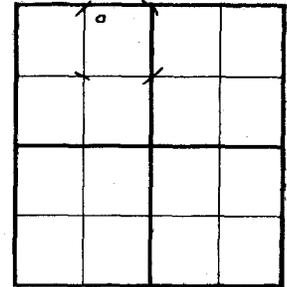

MISCELLANEOUS

Location _____

Rig up _____

Drilling and Remarks:

Dr lg. 950
6 1/2" @ 835
214000 Gas.

RECORD

Cased _____ in., _____ ft.

Sand _____

Gas _____

Oil _____

Total Depth 1020

PRODUCTION

1st 24 hrs. Nat. _____

1st 24 hrs. after shot _____

Gas _____ Cu. Ft.

Dry Hole _____

Abandoned _____

Date

JUN 21 1939 19

S. J. LEWIS Scout

Sec. 3 Twp. 14 R. 22-E

Well No. #1 Johnson Farm

Cowan et al Company


(Miscellaneous)

360 Ft. from N. Line

_____ Ft. from S. Line

960 Ft. from E. Line

_____ Ft. from W. Line

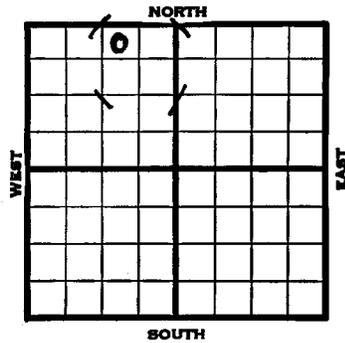


Section 3 Township 14 Range 22-E

Well No. #1 Johnson

Company Cowan et al

Miscellaneous

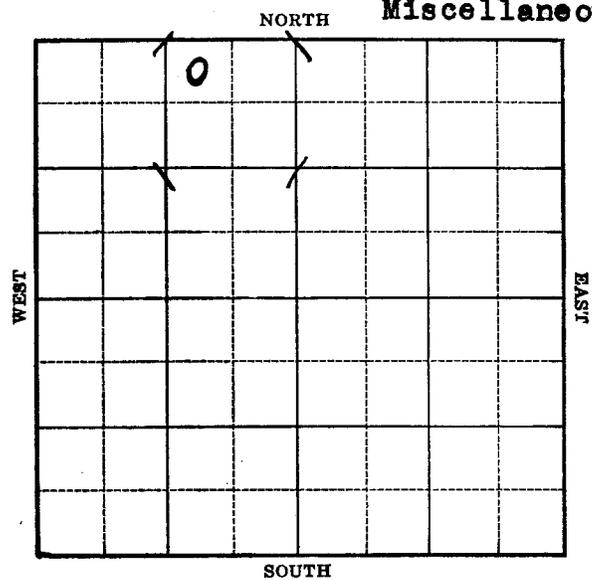

*T.D. 1020
Burgess Sr.*

REPORT

1939	
5/31	Drlg. 358' Machine.
6/8	Mach. Drlg. 358'
6/16	836' run 6".
6/21	Burgess 950'
	6-5/8" - 835'
	T.D. 1020'
	214,000 gas.

COMPLETED