

Form 26-1M Bks.-2-29 Johnson **KANSAS**  
Map No. NM Sec. 22 Twp. 14 R. 22E

Well No. 1 Quintance  
T. W. Reid etal Company  
Contractor

**FIRST REPORT**

**SW NW**

Ft. from N. Line

**220**

Ft. from S. Line

Ft. from E. Line

**220**

Ft. from W. Line

**WILDCAT**

**SECTION PLAT**


Form 26-1M Bks.-2-29 Johnson  
Map No. Sec. 12 Twp. 14 R. 22E

Well No. 1 Quintance  
T. W. Reid etal Company  
Contractor

**CORRECTION**

**SECTION PLAT**

**SW NW**

Ft. from N. Line

**220**

Ft. from S. Line

Ft. from E. Line

**220**

Ft. from W. Line

**WILDCAT**


Location _____ Rig up _____ Drilling and Remarks: <b>Drlg. 150</b>	<b>RECORD</b> Cased _____ in., _____ ft. Sand _____ Gas _____ Oil _____ Total Depth _____
	<b>PRODUCTION</b> 1st 24 hrs. Nat. _____ 1st 24 hrs. after shot _____ Gas _____ Cu. Ft. Dry Hole _____ Abandoned _____

Date **MAY 17 1939** 19 **S. J. LEWIS** Scout

Location _____ Rig up _____ Drilling and Remarks: <b>Reported</b> <b>22-14-22E</b>	<b>RECORD</b> Cased _____ in., _____ ft. Sand _____ Gas _____ Oil _____ Total Depth _____
	<b>PRODUCTION</b> 1st 24 hrs. Nat. _____ 1st 24 hrs. after shot _____ Gas _____ Cu. Ft. Dry Hole _____ Abandoned _____

Date **JUN 3 1939** 19 **S. J. LEWIS** Scout




Johns on **KANSAS**

Section 12 ~~22~~ Township 14 Range 22-E

Well No. 1 Quintance

Company T. W. Reid et al

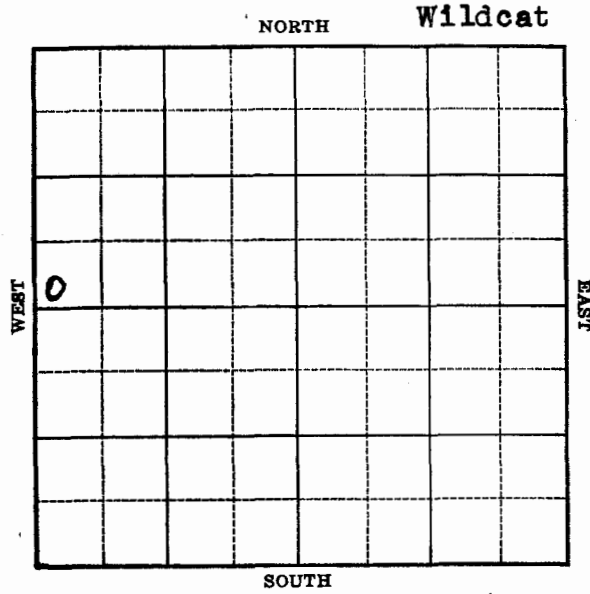

TD 946