

Map No. NM Sec. 15 Twp. 14 R. 22E

Sec. 15 Twp. 14 R. 22-E

Well No. 2 Bigelow

Well No. #2 Bigelow Farm

Spearman & Trammel Company

Spearman & Trammel Company


Contractor

(Miscellaneous)


FIRST REPORT

SECTION PLAT

**C E L N E S W**  
150 Ft. from N. Line  
 \_\_\_\_\_ Ft. from S. Line  
480 Ft. from E. Line  
 \_\_\_\_\_ Ft. from W. Line

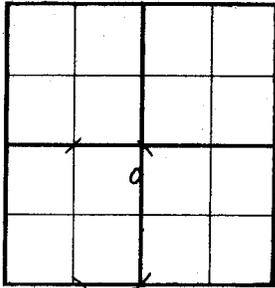

150 Ft. from N. Line  
 \_\_\_\_\_ Ft. from S. Line  
480 Ft. from E. Line  
 \_\_\_\_\_ Ft. from W. Line

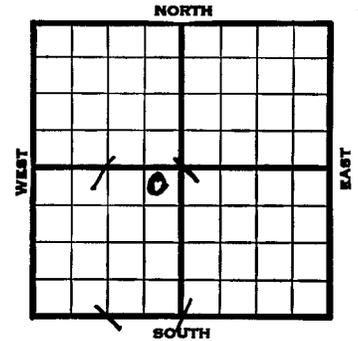

MISCELLANEOUS

Location \_\_\_\_\_  
 Rig up \_\_\_\_\_  
 Drilling and Remarks:  
10" @ 21  
Drig. 80'  
Mach.

**RECORD**  
 Cased \_\_\_\_\_ in., \_\_\_\_\_ ft.  
 Sand \_\_\_\_\_  
 Gas \_\_\_\_\_  
 Oil \_\_\_\_\_  
 Total Depth \_\_\_\_\_  
**PRODUCTION**  
 1st 24 hrs. Nat. \_\_\_\_\_  
 1st 24 hrs. after shot \_\_\_\_\_  
 Gas \_\_\_\_\_ Cu. Ft.  
 Dry Hole \_\_\_\_\_  
 Abandoned \_\_\_\_\_

Date  
JUN 21 1939 19 S. J. LEWIS Scout

1939	REPORT
6/27	10" - 21'
	Drig. 80' Machine.
6/29	S. G. 589' 6" - 814' Drig.
7/6	T.D. 842' Sand 822-39'
	Estimated 12 bbls. per day.
7/12	Sand 822'
	6" - 814'
	T.D. 842'
	Shot 40 qts. 822-39'
	10 bbls. oil.
	COMPLETED

Johnson KANSAS

Map No. MM Sec. 15 Twp. 14 R. 22E

Well No. 2 Bigelow

Spearman & Trammel Company

Contractor

COMPLETED

C E L NE SW


150 Ft. from N. Line

\_\_\_\_\_ Ft. from S. Line

480 Ft. from E. Line

\_\_\_\_\_ Ft. from W. Line

SECTION PLAT

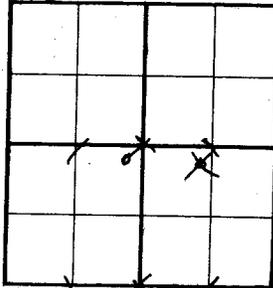

MISCELLANEOUS

Location \_\_\_\_\_

Rig up \_\_\_\_\_

Drilling and Remarks:

*Sand 822.*

*6" @ 814*

*40 qts. 822-39*

*10846*

RECORD

Cased \_\_\_\_\_ in., \_\_\_\_\_ ft.

Sand \_\_\_\_\_

Gas \_\_\_\_\_

Oil \_\_\_\_\_

Total Depth 842

PRODUCTION

1st 24 hrs. Nat. \_\_\_\_\_

1st 24 hrs. after shot \_\_\_\_\_

Gas \_\_\_\_\_ Cu. Ft.

Dry Hole \_\_\_\_\_

Abandoned \_\_\_\_\_

Date

JUL 12 1938

19

S. J. LEWIS

Scout

Johnson

Map No. \_\_\_\_\_ Sec. 15 Twp. 14 R. 22E

Well No. 2 Bigelow

Spearman & Trammel Company

Contractor

CORRECTION

C E L NE SW


150 Ft. from N. Line

\_\_\_\_\_ Ft. from S. Line

480 Ft. from E. Line

\_\_\_\_\_ Ft. from W. Line

SECTION PLAT

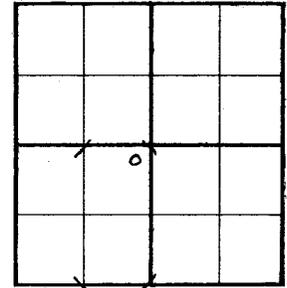

MISCELLANEOUS

Location \_\_\_\_\_

Rig up \_\_\_\_\_

Drilling and Remarks:

*Sand 882*

*6" @ 814*

*40 qts. 822-39*

*10 bbls.*

RECORD

Cased \_\_\_\_\_ in., \_\_\_\_\_ ft.

Sand \_\_\_\_\_

Gas \_\_\_\_\_

Oil \_\_\_\_\_

Total Depth 842

PRODUCTION

1st 24 hrs. Nat. \_\_\_\_\_

1st 24 hrs. after shot \_\_\_\_\_

Gas \_\_\_\_\_ Cu. Ft.

Dry Hole \_\_\_\_\_

Abandoned \_\_\_\_\_

Date

JUL 12 1938

19

S. J. LEWIS

Scout

Section 15 Township 14 Range 22-E

Well No. #2 Bigelow

Company Spearman & Trammel

