

Johnson KANSAS

Map No. MM Sec. 15 Twp. 14 R. 22EWell No. 1 JewettA. G. Blaumer

Company

Contractor

FIRST REPORT

SECTION PLAT

SE SW

Ft. from N. Line

150

Ft. from S. Line

150

Ft. from E. Line

Ft. from W. Line

	0		

MISCELLANEOUS

Location

Rig up

Drilling and Remarks:

8" - 156Dr lg. 220

RECORD

Cased in., ft.

Sand

Gas

Oil

Total Depth

PRODUCTION

1st 24 hrs. Nat.

1st 24 hrs. after shot

Gas Cu. Ft.

Dry Hole

Abandoned

Date

JUN 28 1939 19S. J. LEWIS

Scout

Johnson KANSAS

Map No. Sec. 15 Twp. 14 R. 22EWell No. 1 JewettA. G. Blaumer

Company

Contractor

COMPLETED

SECTION PLAT

SE NW

Ft. from N. Line

150

Ft. from S. Line

150

Ft. from E. Line

Ft. from W. Line

	0		

MISCELLANEOUS

Location

Rig up

Drilling and Remarks:

Sand 825Pay 827-39@ 825.shot 407 to10 886

RECORD

Cased in., ft.

Sand

Gas

Oil

Total Depth 840

PRODUCTION

1st 24 hrs. Nat.

1st 24 hrs. after shot

Gas Cu. Ft.

Dry Hole

Abandoned

Date

JUL 12 1939 19S. J. LEWIS

Scout

Sec. 15 Twp. 14 R. 22-E

Well No. #1 Jewett Farm

A. G. Blaumer Company

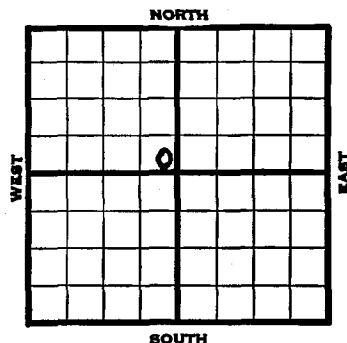
(Miscellaneous)

_Ft. from N. Line

150 Ft. from S. Line

750 Ft. from E. Line

_Ft. from W. Line

[illegible]

Johnson

KANSAS

Section 15 Township 14 Range 22-E

Well No. #1 Jewett

Company A. G. Blaumer

NORTH Miscellaneous

