

Johnson

KANSAS

Map No. NM Sec. 15 Twp. 14 R. 22E

Well No. 1 Knabe

O. K. Supply Company

Contractor

FIRST REPORT

C NE NE

660 Ft. from N. Line

Ft. from S. Line

660 Ft. from E. Line

Ft. from W. Line

WILDCAT

SECTION PLAT

			0

Location _____

Rig up _____

Drilling and Remarks:

Drlg. 250

RECORD

Cased _____ in., _____ ft.

Sand _____

Gas _____

Oil _____

Total Depth _____

PRODUCTION

1st 24 hrs. Nat. _____

1st 24 hrs. after shot _____

Gas _____ Cu. Ft.

Dry Hole _____

Abandoned _____

Date

APR 12 1939 19

H. D. Hatfield Scout

Johnson

KANSAS

Map No. NM Sec. 15 Twp. 14 R. 22E

Well No. 1 Knabe

O.K. Supply Company

Contractor

COMPLETED

C NE NE

660 Ft. from N. Line

Ft. from S. Line

660 Ft. from E. Line

Ft. from W. Line

WILDCAT

SECTION PLAT

			0

Location _____

Rig up _____

Drilling and Remarks:

Lower Part 830

Shot 409 to 705-725.

Pump. 30 x 1/2

RECORD

Cased _____ in., _____ ft.

Sand _____

Gas _____

Oil _____

Total Depth 857

PRODUCTION

1st 24 hrs. Nat. _____

1st 24 hrs. after shot _____

Gas _____ Cu. Ft.

Dry Hole _____

Abandoned _____

Date

MAY 10 1939 19

S. J. LEWIS Scout

Sec. 15 Twp. 14 R. 22-E

Well No. #1 Knabe Farm

O. K. Supply Company


(Wildcat)

660 Ft. from N. Line

_____ Ft. from S. Line

660 Ft. from E. Line

_____ Ft. from W. Line

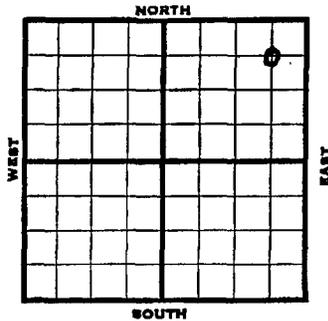

1939

5/10

Lower Bart 830'
T.D. 857'
Shot 40 qts. 705-725'
Pump 30 bbls.

COMPLETED

1939	REPORT
4/12	Drig. 250'
4/21	8" - 620' Drig. 678'
4/24	1st Bartlesville 705-28
	Est. 5 to 8 bbl. well 32 Gravity
	2nd Bartlesville 830-56 T.D. 856
	Had 20' pay Shot 40 qts.
	Estimate 25 to 100 bbl. well
	(This sand was 26 gravity) (Tel)
4/ 28	Squirrel sand 705-28'
	Est. 5 bbls. per day Natural.
	Bartlesville sand 830-56'
	T.D. 857'
	Shot 50 qts. 830-50'
	Shot 40 qts. 705-25'
	Est. 25 to 50 bbls. per day.
	Gravity upper pay 32.
	Gravity lower pay 26.
5/5	Perf. casing 2707-20'
	Estimated 40 bbls. oil per day.
	OVER

Section 15 Township 14 Range 22-E

Well No. 1 Knabe

Company O. K. Supply

