

Map No. *MM* Sec. 15 Twp. 14 R. 22E

Well No. 4 Knabe "B"

O.K. Supply Company

FIRST REPORT Contractor

COMPLETED

SECTION PLAT


SE SW SW NE

Ft. from N. Line

150 Ft. from S. Line

Ft. from E. Line

480 Ft. from W. Line

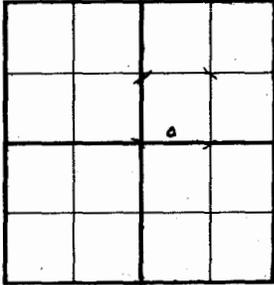

MISCELLANEOUS

Location _____

Rig up _____

Drilling and Remarks:

8" - 20

680-85 Squirrel

Bart. 796-820 TD

6" - 796

Shot 20qts.

796 - 820

Pumped 15 bbls.

Completed

RECORD

Cased _____ in., _____ ft.

Sand _____

Gas _____

Oil _____

_____ Depth _____

PRODUCTION

1st 24 hrs. Nat. _____

1st 24 hrs. after shot _____

Gas _____ Cu. Ft.

Dry Hole _____

Abandoned _____

Date

SEP 13 1939 19

S. J. LEWIS

Scout

Sec. 15 Twp. 14 R. 22-E

Well No. #4 Knabe "B" Farm _____

O. K. Supply Company


(Miscellaneous)

Ft. from N. Line

150 Ft. from S. Line

Ft. from E. Line

480 Ft. from W. Line

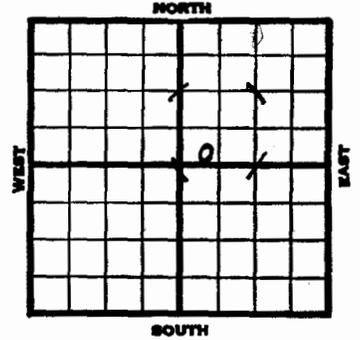

1939

REPORT

9/13 8" - 20'

Squirrel 680-85'

Bart. 796-820'

T.D. 820' 6" - 796'

Shot 20 qts. 796-820'

Pumped 15 bbls. oil.

FIRST REPORT

anf
COMPLETED

KANSAS Johnson

Form 51-5M-11-38-Palace

Section 15 Township 14 Range 22-E

Well No. #4 Knabe "B"

Company O. K. Supply

