

Johnson KANSAS

Map No. 11M Sec. 15 Twp. 14 R. 22EWell No. 5 Knabe "B"O. K. Supply Company

Contractor

FIRST REPORT

SW NE SW NE

Ft. from N. Line

700 Ft. from S. Line

Ft. from E. Line

810 Ft. from W. Line

SECTION PLAT

MISCELLANEOUS

Location

Rig up

Drilling and Remarks:

8" - 21Drig. 600

RECORD

Cased _____ in., _____ ft.

Sand _____

Gas _____

Oil _____

Total Depth _____

PRODUCTION

1st 24 hrs. Nat. _____

1st 24 hrs. after shot _____

Gas _____ Cu. Ft.

Dry Hole _____

Abandoned _____

Date

SEP 13 1939 19S. J. LEWIS

Scout

Johnson KANSAS

Map No. 11M Sec. 15 Twp. 14 R. 22EWell No. 5 Knabe "B"O. K. Supply Company

Company

Contractor

ABANDONED

SECTION PLAT

SW NE SW NE

Ft. from N. Line

700 Ft. from S. Line

Ft. from E. Line

810 Ft. from W. Line

MISCELLANEOUS

Location

Rig up

Drilling and Remarks:

RECORD

Cased _____ in., _____ ft.

Sand _____

Gas _____

Oil _____

Total Depth 600

PRODUCTION

1st 24 hrs. Nat. _____

1st 24 hrs. after shot _____

Gas _____ Cu. Ft.

Dry Hole _____

Abandoned _____

Date

SEP 20 1939 19S. J. LEWIS

Scout

Sec. 15 Twp. 14 R. 22-E

Well No. #5 Knabe "B" Farm

O. K. Supply Company


(Miscellaneous)

Ft. from N. Line

700 Ft. from S. Line

Ft. from E. Line

810 Ft. from W. Line

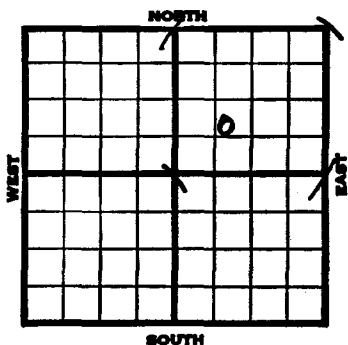

REPORT

1939

9/13 8" - 21'

Drlg. 600'

9/20 T.D. 600'

ABANDONED

Section 15 Township 14 Range 22-E

Well No. #5 Knabe "B"

Company O. K. Supply

NORTH Miscellaneous

