Form 26—1M Bks.—2-29 Johnson KANSAS

Map No. NM Sec. 15 Twp. 14 R. 22E

Well No. 4 Knabe

O.K. Supply & Blaumer Company

Contractor

FIRST REPORT

NE SE NE

Ft. from N. Line


1170 Ft. from S. Line

150 Ft. from E. Line

Ft. from W. Line

MISCELLANEOUS

SECTION PLAT

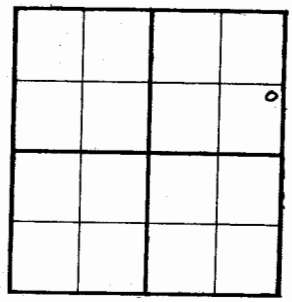

Location

Rig up

Drilling and Remarks:

Machine

10" - 12'

Drlg. 345'

RECORD

Cased in., ft.

Sand

Gas

Oil

Total Depth

PRODUCTION

1st 24 hrs. Nat.

1st 24 hrs. after shot

Gas Cu. Ft.

Dry Hole

Abandoned

Date

JUL 26 1939 19

S. J. LEWIS Scout

Form 26—1M Bks.—2-29 Johnson KANSAS

Map No. NM Sec. 15 Twp. 14 R. 22E

Well No. 1 Knabe "C"

O.K.Supply & Blaumer Company

CORRECTION Contractor

NE SE NE


Ft. from N. Line

1170 Ft. from S. Line

150 Ft. from E. Line

Ft. from W. Line

SECTION PLAT

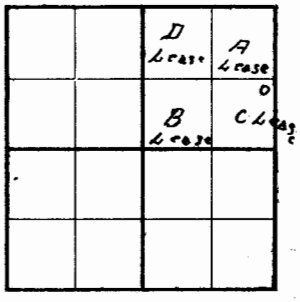

Reported:

as #4 Knabe

Location

Rig up

Drilling and Remarks:

RECORD

Cased in., ft.

Sand

Gas

Oil

Total Depth

PRODUCTION

1st 24 hrs. Nat.

1st 24 hrs. after shot

Gas Cu. Ft.

Dry Hole

Abandoned

Date

AUG 2 1939 19

S. J. LEWIS Scout

Form 26—1M Bks.—2-29 Johnson KANSAS

Map No. Sec. 15 Twp. 14 R. 22E

Well No. 4 Knabe

O.K.Supply & Blaumer Company

Contractor

COMPLETED

NE SE NE


Ft. from N. Line

1170 Ft. from S. Line

150 Ft. from E. Line

Ft. from W. Line

SECTION PLAT

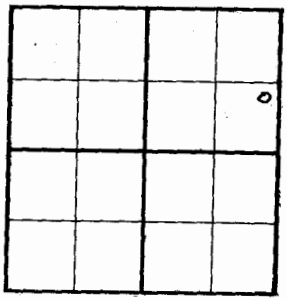

MISCELLANEOUS

Location

Rig up

Drilling and Remarks:

Squirrel Sd 715

Bar T 832-46

Shot T 20 qts 832-46

Pump 10 Bbls

RECORD

Cased in., ft.

Sand

Gas

Oil

Total Depth 852

PRODUCTION

1st 24 hrs. Nat.

1st 24 hrs. after shot

Gas Cu. Ft.

Dry Hole

Abandoned

Date

AUG 2 1939 19

S. J. LEWIS Scout

FORM 252-A 5M 4-39 KANSAS Johnson

Sec. 15 Twp. 14 R. 22-E

Well No. ~~4~~ Knabe #1-"C" Farm

O. K. Supply & Blaumer Company


(Miscellaneous)

Ft. from N. Line

1170 Ft. from S. Line

150 Ft. from E. Line

Ft. from W. Line

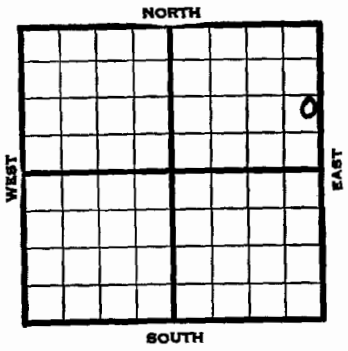

1939	REPORT
7/26	Machine.
	10" - 12'
	Drlg. 345'
8/2	Squirrel sand 715'
	Bart. 832-46'
	T.D. 852'
	Shot 20 qts. 832-46'
	Pump 10 bbls.
	COMPLETED

KANSAS

Form 61—5M—11-38—Palace

Johnson

Section 15 Township 14 Range 22-E

Well No. ~~#4~~ Knabe #1-C

Company O.K. Supply & Blaumer

