

Map No. NM Sec. 15 Twp. 14 R. 22E

Well No. 2 Kanabe

O.K.O. Supply Company

Contractor

FIRST REPORT

SECTION PLAT

330 Ft. from N. Line
Ft. from S. Line
990 Ft. from E. Line
Ft. from W. Line

			0

WILDCAT

Location _____

RECORD

Cased _____ in., _____ ft.
Sand _____
Gas _____
Oil _____
Total Depth _____

Rig up _____
Drilling and Remarks:

100,000 Gas 665'
Sand 700-23
200' Oil in 5hrs.
Shot 60 quarts
600' Oil in 12hrs.
Drig. 780

PRODUCTION

1st 24 hrs. Nat. _____
1st 24 hrs. after shot _____
Gas _____ Cu. Ft.
Dry Hole _____
Abandoned _____

Date
MAY 24 1939

S. J. LEWIS Scout

Map No. NM Sec. 15 Twp. 14 R. 22E

Well No. 2 Kanabe

O K O Supply Company

Contractor

COMPLETED

SECTION PLAT

330 Ft. from N. Line
Ft. from S. Line
990 Ft. from E. Line
Ft. from W. Line

			0

WILDCAT

Location _____

RECORD

Cased _____ in., _____ ft.
Sand _____
Gas _____
Oil _____
Total Depth 288

Rig up _____
Drilling and Remarks:

Burgess 982
6' @ 701
715987
98854

PRODUCTION

1st 24 hrs. Nat. _____
1st 24 hrs. after shot _____
Gas _____ Cu. Ft.
Dry Hole _____
Abandoned _____

Date
JUN 21 1939

S. J. LEWIS Scout

KANSAS

Johnson

Sec. 15 Twp. 14 R. 22-E

Well No. #2 Kanabe Farm _____

O. K. O. Supply Company _____


(Wildcat)

330 Ft. from N. Line

_____ Ft. from S. Line

990 Ft. from E. Line

_____ Ft. from W. Line

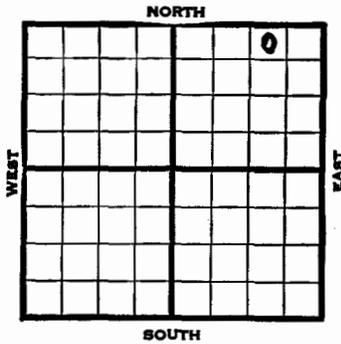


KANSAS

Johnson

Section 15 Township 14 Range 22-E

Well No. 2 Kanabe

Company O.K.O. Supply

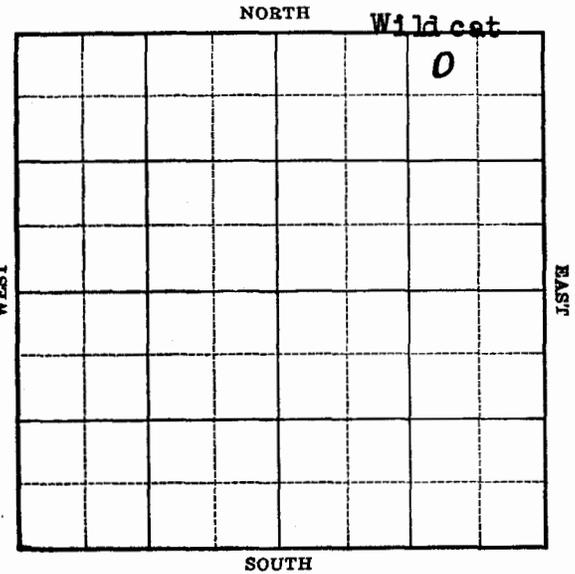

1939	REPORT
5/24	100,000 gas 665' Sand 700-23' 200' oil in 5 hours. Shot 60 qts. 600' oil in 12 hours. Drilg. 780'
6/1	Barth. sand 830' T.D. 858' in sand.
6/8	" " " "
6/16	1000 acid. No results. 5" - 820' Drilg. 970'
6/21	Burgess 982' 6" - 701' T.D. 987' P. B. 854' Pump 10 bbls. per day.
	COMPLETED