

Map No. NM Sec. 15 Twp. 14 R. 22E

Well No. 1 McCann

Gardener Oil Company

Contractor

FIRST REPORT

NW NE SE


150 Ft. from N. Line

\_\_\_\_\_ Ft. from S. Line

1170 Ft. from E. Line

\_\_\_\_\_ Ft. from W. Line

SECTION PLAT

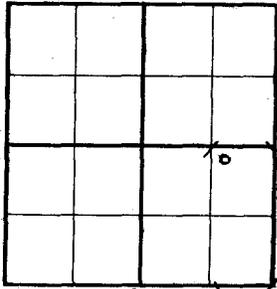

WILDCAT

Location \_\_\_\_\_

RECORD

Cased \_\_\_\_\_ in., \_\_\_\_\_ ft.

Sand \_\_\_\_\_

Gas \_\_\_\_\_

Oil \_\_\_\_\_

Total Depth \_\_\_\_\_

PRODUCTION

1st 24 hrs. Nat. \_\_\_\_\_

1st 24 hrs. after shot \_\_\_\_\_

Gas \_\_\_\_\_ Cu. Ft.

Dry Hole \_\_\_\_\_

Abandoned \_\_\_\_\_

Rig up \_\_\_\_\_

Drilling and Remarks:

Hertha. 369-76

Drlg. 654

Date

JAN 3 1940 19

S. J. LEWIS

Scout

Map No. NM Sec. 15 Twp. 14 R. 22E

Well No. 1 McCann

Gardener Oil Company

Contractor

COMPLETED

NW NE SE


150 Ft. from N. Line

\_\_\_\_\_ Ft. from S. Line

1170 Ft. from E. Line

\_\_\_\_\_ Ft. from W. Line

SECTION PLAT

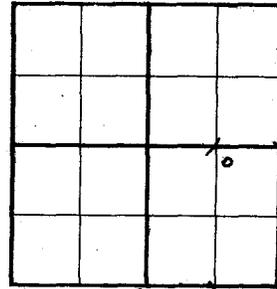

WILDCAT

Location \_\_\_\_\_

RECORD

Cased \_\_\_\_\_ in., \_\_\_\_\_ ft.

Sand \_\_\_\_\_

Gas \_\_\_\_\_

Oil \_\_\_\_\_

Total Depth 850

PRODUCTION

1st 24 hrs. Nat. \_\_\_\_\_

1st 24 hrs. after shot \_\_\_\_\_

Gas \_\_\_\_\_ Cu. Ft.

Dry Hole \_\_\_\_\_

Abandoned \_\_\_\_\_

Rig up \_\_\_\_\_

Drilling and Remarks:

Bar Y 533

1" C 531 1/2

Bar Y 597 1/2

58 1/2

Date

FEB 28 1940 19

S. J. LEWIS

Scout

Sec. 15 Twp. 14 R. 22-E

Well No. #1 McCann Farm

Gardener Oil Company


(Wildcat)

150 Ft. from N. Line

\_\_\_\_\_ Ft. from S. Line

1170 Ft. from E. Line

\_\_\_\_\_ Ft. from W. Line

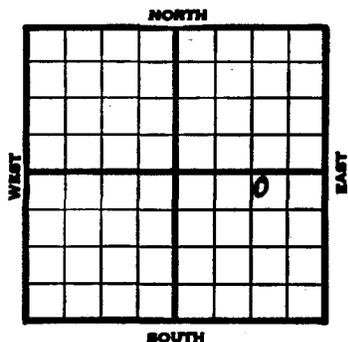

1940	REPORT
1/3	Hertha. 369-76' Drl g. 654'8
1/11	SD 654'
1/18	6" - 660' Bart. 833' T.D. 850' 240' oil. U.R. 6".
1/25	Shut down.
2/1	" "
2/8	6" - 831½' T.D. 850' Shot 5 qts.
2/15	5 bailers oil a day.
2/23	" " " "
2/28	Bart. 833' 6" - 831½' T.D. 850' Shot 50 qts. 5 bbls. oil.
COMPLETED	

Section 15 Township 14 Range 22-E

Well No. #1 McCann

Company Gardener Oil

