

Johnson KANSAS

Map No. NM Sec. 15 Twp. 14 R. 22E

Well No. 1 McGann

O. K. Supply Company

Contractor

FIRST REPORT

NE NW NW SE

SECTION PLAT

150 Ft. from N. Line

_____ Ft. from S. Line

_____ Ft. from E. Line

480 Ft. from W. Line

MISCELLANEOUS

Location _____

RECORD

Cased _____ in., _____ ft.

Sand _____

Gas _____

Oil _____

Total Depth _____

PRODUCTION

1st 24 hrs. Nat. _____

1st 24 hrs. after shot _____

Gas _____ Cu. Ft.

Dry Hole _____

Abandoned _____

Rig up _____

Drilling and Remarks:

Machine

Date

SEP 13 1939 19

S. J. LEWIS

Scout

Johnson KANSAS

Map No. NM Sec. 15 Twp. 14 R. 22E

Well No. 1 McGann

O. K. Supply Company

Contractor

COMPLETED

NE NW NW SE

SECTION PLAT

150 Ft. from N. Line

_____ Ft. from S. Line

_____ Ft. from E. Line

480 Ft. from W. Line

MISCELLANEOUS

Location _____

RECORD

Cased _____ in., _____ ft.

Sand _____

Gas _____

Oil _____

Total Depth 121

PRODUCTION

1st 24 hrs. Nat. _____

1st 24 hrs. after shot _____

Gas _____ Cu. Ft.

Dry Hole _____

Abandoned _____

Rig up _____

Drilling and Remarks:

Bar. 800
6" @ 798
Shot 439 to

5 1/2

Date

OCT 25 1939 19


S. J. LEWIS

Scout

Sec. 15 Twp. 14 R. 22-E

Well No. #1 McCann Farm _____
 O. K. Supply Company

(Miscellaneous)
 _____ 150 Ft. from N. Line
 _____ Ft. from S. Line
 _____ Ft. from E. Line
 _____ 480 Ft. from W. Line

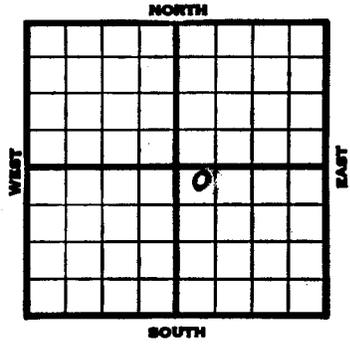

1939	REPORT
9/13	Machine.
9/21	8" - 16' T.D. 360' SD.
9/28	Hertha 345' T.D. 798' Run 6".
10/5	Bart. 800' T.D. 821' Shot 40 qts. Fsg. casing.
10/12	" " " " "
10/19	6" - 798' Shot 3 qts. C.O.
10/25	Bart. 800' 6" - 798' T.D. 821' Shot 43 qts. 5 barrels.
	COMPLETED

Section 15 Township 14 Range 22-E

Well No. #1 McCann

Company O. K. Supply

