

Johnson **KANSAS**

Map No. NM Sec. 15 Twp. 14 R. 22E

Well No. 2 Knabe "C"

O.K. Supply - Blaumer Company

Contractor

FIRST REPORT

NE SE NE

_____ Ft. from N. Line

1170 Ft. from S. Line

405 Ft. from E. Line

_____ Ft. from W. Line

SECTION PLAT

			o

MISCELLANEOUS

Location X

Rig up _____

Drilling and Remarks: _____

RECORD

Cased _____ in., _____ ft.

Sand _____

Gas _____

Oil _____

Total Depth _____

PRODUCTION

1st 24 hrs. Nat. _____

1st 24 hrs. after shot _____

Gas _____ Cu. Ft.

Dry Hole _____

Abandoned _____

Date

AUG 2 1939 19

S. J. LEWIS Scout

Johnson **KANSAS**

Map No. _____ Sec. 15 Twp. 14 R. 22E

Well No. 2 Knabe "C"

O. K. Supply & Blaumer Company

Contractor

CORRECTION

NE SE NE

_____ Ft. from N. Line

1266 Ft. from S. Line

920 Ft. from E. Line

_____ Ft. from W. Line

SECTION PLAT

			o

MISCELLANEOUS

Location _____

Rig up _____

Drilling and Remarks: _____

RECORD

Cased _____ in., _____ ft.

Sand _____

Gas _____

Oil _____

Total Depth _____

PRODUCTION

1st 24 hrs. Nat. _____

1st 24 hrs. after shot _____

Gas _____ Cu. Ft.

Dry Hole _____

Abandoned _____

Date

SEP 6 1939 19

S. J. LEWIS Scout

Johnson KANSAS

Map No. *NM* Sec. 15 Twp. 14 R. 22E

Well No. 2 Knabe "C"

O. K. Supply & Blaumer Company

Contractor

COMPLETED

NEW SE NE

Ft. from N. Line


1266 Ft. from S. Line

920 Ft. from E. Line

Ft. from W. Line

MISCELLANEOUS

SECTION PLAT

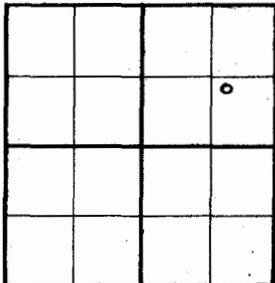

KANSAS

Johnson

Sec. 15 Twp. 14 R. 22-E

Well No. #2 Knabe "C" Farm

O. K. Supply-Blaumer Company

(Miscellaneous)

Ft. from N. Line


1266

1170 Ft. from S. Line

920

405 Ft. from E. Line

Ft. from W. Line

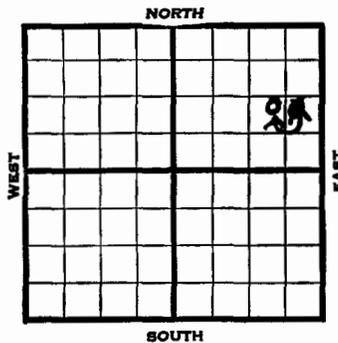

Location

Rig up

Drilling and Remarks:

*Bart 834
6" C 707
Shot 15 qts 834-50*

10 Bbls

RECORD

Cased in., ft.

Sand

Gas

Oil

Total Depth *850*

PRODUCTION

1st 24 hrs. Nat.

1st 24 hrs. after shot

Gas Cu. Ft.

Dry Hole

Abandoned

Date

SEP 6 1939 19

S. J. LEWIS Scout

1939

REPORT

8/2

Location

8/10

6" - 703' sand 834-52' T.D.

No shows reported.

8/17

" " "

8/24

Shut down.

8/31

Shut down.

9/6

Bart. 834'

6" - 707'

T.D. 850'

Shot 15 qts. 834-50'

10 bbls. oil.

COMPLETED

Johnson KANSAS

Form 51-5M-11-38-Palace

Section 15 Township 14 Range 22-E

Well No. #2 Knabe "C"

Company O. K. Supply- Blaumer

