

Johnson **KANSAS**Map No. 11 Sec. 16 Twp. 14 R. 22EWell No. 1 FlacyE. Smith etal Company

Contractor

FIRST REPORT

SECTION PLAT


C SE SE

Ft. from N. Line

565 Ft. from S. Line785 Ft. from E. Line

Ft. from W. Line

WILDCAT

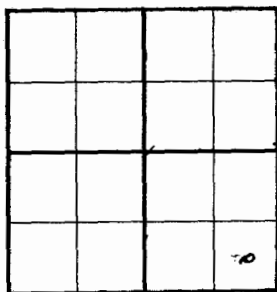

Location

RECORD

Cased in., ft.

Sand

Gas

Oil

Total Depth

PRODUCTION

1st 24 hrs. Nat.

1st 24 hrs. after shot

Gas Cu. Ft.

Dry Hole

Abandoned

Date

JUL 19 1939 19

S. J. LEWIS

Scout

Johnson **KANSAS**Map No. 11 Sec. 16 Twp. 14 R. 22EWell No. 1 FlacyE. Smith etal Company

Contractor

Contractor

ABANDONED

SECTION PLAT


C SE SE

Ft. from N. Line

565 Ft. from S. Line785 Ft. from E. Line

Ft. from W. Line

WILDCAT

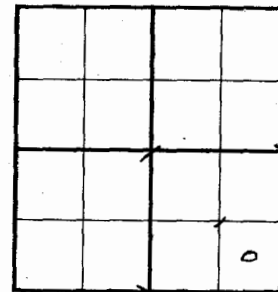

Location

RECORD

Cased in., ft.

Sand

Gas

Oil

Total Depth 910

PRODUCTION

1st 24 hrs. Nat.

1st 24 hrs. after shot

Gas Cu. Ft.

Dry Hole

Abandoned

Date

AUG 2 1939 19

S. J. LEWIS

Scout

Sec. 16 Twp. 14 R. 22-EWell No. #1 Flacy Farm

E. Smith et al Company


(Wildcat)

Ft. from N. Line

565 Ft. from S. Line

785 Ft. from E. Line

Ft. from W. Line

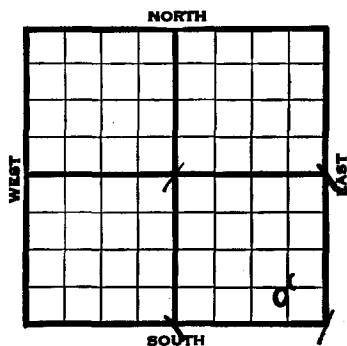

1939

REPORT

7/19 10" - 45' Drlg. 380'
 7/27 Herta 406' Base Herta 427'

8" - 702' T.D. 845' SD.

8/2 Bart. 838-98'

T.D. 910'

ABANDONED

Section 16 Township 14 Range 22-EWell No. #1 FlacyCompany E. Smith et al