

Johnson (Kans) KANSAS

KANSAS Johnson

Map No. NM Sec. 20 Twp. 14 R. 22E

Sec. 20 Twp. 14 R. 22-E

Well No. 1 Metropolitan Life Ins.

Well No. #1 Metropolitan Life Ins. Farm

Sagamore Oil & Gas (Twin to Gas Well)  
(No Record) Company

Sagamore Oil & Gas. Company


FIRST REPORT

Contractor

COMPLETED


SECTION PLAT

SW SE SE

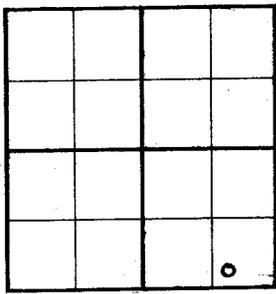

\_\_\_\_\_ Ft. from N. Line  
330 Ft. from S. Line  
990 Ft. from E. Line  
\_\_\_\_\_ Ft. from W. Line

\_\_\_\_\_ Ft. from N. Line  
330 Ft. from S. Line  
990 Ft. from E. Line  
\_\_\_\_\_ Ft. from W. Line

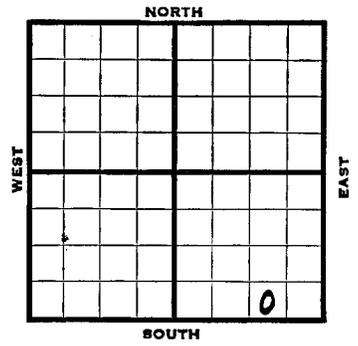

(Twin to gas Well)

Location \_\_\_\_\_

Rig up \_\_\_\_\_

Drilling and Remarks:

Sand 884-90  
TD 903 - 6" 874  
Est. 2 bbls per day  
Shot 20 Qts  
Est. 15 to 20  
bbls. per day  
Grav. 18.  
Completed

RECORD

Cased \_\_\_\_\_ ft. \_\_\_\_\_ ft.  
Sand \_\_\_\_\_  
Gas \_\_\_\_\_  
Oil \_\_\_\_\_  
Total Depth \_\_\_\_\_  
1st 24 hrs. Nat. \_\_\_\_\_  
1st 24 hrs. after shot \_\_\_\_\_  
Gas \_\_\_\_\_ Cu. Ft.  
Dry Hole \_\_\_\_\_  
Abandoned \_\_\_\_\_

1939 REPORT

4/26 Sand 884-90'  
T. D. 903' 6" - 874'  
Est. 2 bbls. per day.  
Shot 20 qts.  
Est. 15 to 20 bbls. oil per day.  
Gravity 18.

FIRST REPORT

*and*  
COMPLETED

Date \_\_\_\_\_

APR 26 1939 19 \_\_\_\_\_ H. D. Hatfield Scout


KANSAS Johnson

Form 51-5M-11-38-Palace

Section 20 Township 14 Range 22-E

Well No. #1 Metropolitan Life Ins.

Company Sagamore Oil & Gas

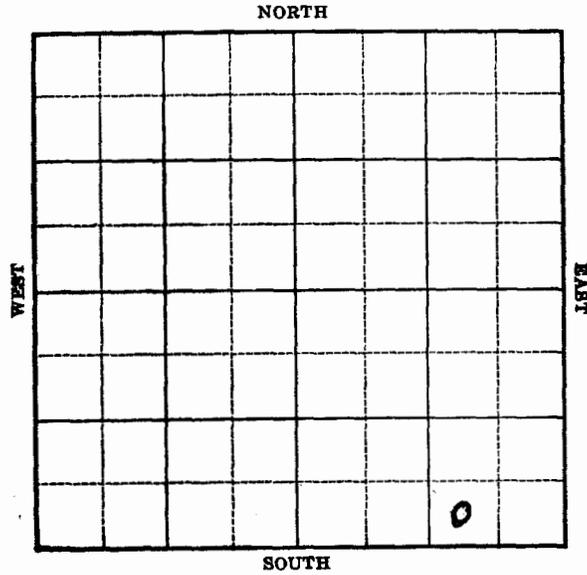

70903