

Johnson KANSAS

Map No. 11 Sec. 29 Twp. 14 R. 22EWell No. 1 H. Knabe


Sagamore Oil & Gas Company

Contractor

FIRST REPORT

SECTION PLAT

NE NW
200 Ft. from N. Line
 _____ Ft. from S. Line
200 Ft. from E. Line
 _____ Ft. from W. Line

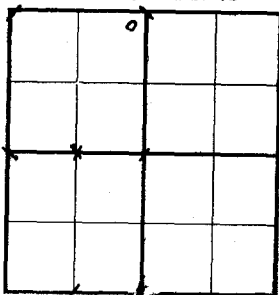

WILDCAT

Location _____

RECORD

Cased _____ in., _____ ft.
 Sand _____
 Gas _____
 Oil _____
 Total Depth _____

PRODUCTION

1st 24 hrs. Nat. _____
 1st 24 hrs. after shot _____
 Gas _____ Cu. Ft.
 Dry Hole _____
 Abandoned _____

Date

MAY 24 1939

19

S. J. LEWIS

Scout

Johnson KANSAS

Map No. 11 Sec. 29 Twp. 14 R. 22EWell No. 1 H. Knabe


Sagamore Oil & Gas Company

Contractor

COMPLETE

SECTION PLAT

NE NW
200 Ft. from N. Line
 _____ Ft. from S. Line
200 Ft. from E. Line
 _____ Ft. from W. Line

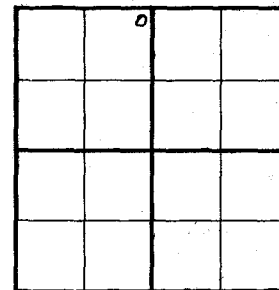

WILDCAT

Location _____

RECORD

Cased _____ in., _____ ft.
 Sand _____
 Gas _____
 Oil _____
 Total Depth 761

PRODUCTION

1st 24 hrs. Nat. _____
 1st 24 hrs. after shot _____
 Gas _____ Cu. Ft.
 Dry Hole _____
 Abandoned _____

Date

MAY 31 1939

19

S. J. LEWIS

Scout

KANSAS

Johnson

Sec. 29 Twp. 14 R. 22-EWell No. #1 H. Knabe FarmSagamore Oil & Gas Company


(Wildcat)

200 Ft. from N. Line

Ft. from S. Line


200 Ft. from E. Line

Ft. from W. Line

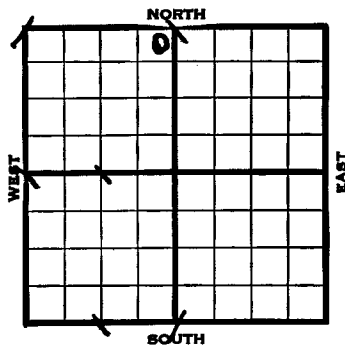

Johnson

KANSAS

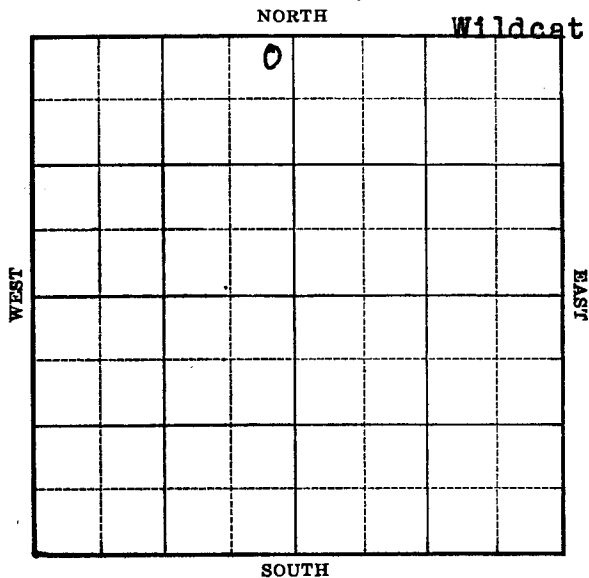Section 29 Township 14 Range 22-EWell No. 1 H. KnabeCompany Sagamore Oil & Gas

1939

REPORT

5/24

Machine.

Dril g. 175'

5/31

Bart. 748'

8" - 740'

T.D. 761'

1/2 M gas.

230# rock pressure.

COMPLETED