

Johnson KANSAS

Map No. NM Sec. 29 Twp. 14 R. 22EWell No. 2 Knabe

Sagamore Oil & Gas Company

Contractor

FIRST REPORT

SE NE NW

1105 Ft. from N. Line

Ft. from S. Line

250 Ft. from E. Line

Ft. from W. Line

SECTION PLAT

	o		

MISCELLANEOUS

Location

Rig up

Drilling and Remarks:

8 1/4" @ 642Drlg. 642

RECORD

Cased in., ft.

Sand

Gas

Oil

Total Depth

PRODUCTION

1st 24 hrs. Nat.

1st 24 hrs. after shot

Gas Cu. Ft.

Dry Hole

Abandoned

Date

MAY 31 1939 19

S. J. LEWIS

Scout

Johnson KANSAS

Map No. NM Sec. 29 Twp. 14 R. 22EWell No. 2 Knabe

Sagamore Oil & Gas Company

Contractor

COMPLETED

SE NE NW

1105 Ft. from N. Line

Ft. from S. Line

250 Ft. from E. Line

Ft. from W. Line

SECTION PLAT

	o		

MISCELLANEOUS

Location

Rig up

Drilling and Remarks:

Land 6705
6" @ 705472,000 Gas.

RECORD

Cased in., ft.

Sand

Gas

Oil

Total Depth 228

PRODUCTION

1st 24 hrs. Nat.

1st 24 hrs. after shot

Gas Cu. Ft.

Dry Hole

Abandoned

Date

JUN 14 1939

S. J. LEWIS

Scout

Sec. 29 Twp. 14 R. 22-E

Well No. #2 Knabe Farm

Sagamore Company

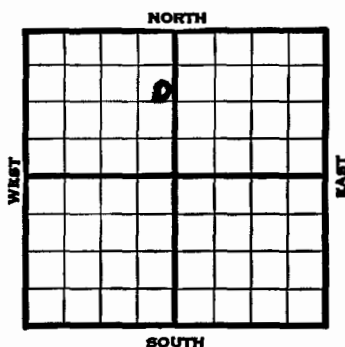
(Miscellaneous)

1105 Ft. from N. Line

_Ft. from S. Line

250 _____ Ft. from E. Line

Ft. from W. Line

[illegible]

Johnson

Section 29 Township 14 Range 22-E

Well No. **#2 Knabe**

Company Sagamore Oil & Gas

Miscellaneous

