

SAGAMORE OIL AND GAS COMPANY
INDEPENDENCE, KANSAS

4-14-226

Company Sagamore Oil and Gas Company

S. T. R. 4-14-22
County Johnson
State Kansas
Lease and Gardner #2
Well No.

Contractor B. Earl Smith

Drilling Commenced 3/24/41


Drilling Completed 3/29/41

Initial Production Gas well

Initial Rock Pressure

Location 370' N and 1270' E of SW corner NE $\frac{1}{4}$

Casing 8 $\frac{1}{2}$ " 17'6"

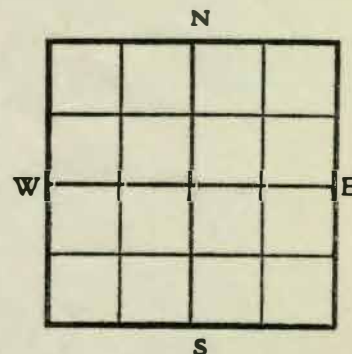

Driller's Record of Formations

lime shells & clay	10	10
shale	6	16
lime	23	39
shale	12	51
lime	72	123
shale	44	167
lime	4	171
shale	2	173
lime	3	176
shale	21	197
lime	7	204
shale	10	214
lime	8	222
shale	2	224
lime	3	227
shale	3	235
lime	3	238
shale	2	240
lime	2	242
shale	4	246
lime	11	257
shale	1	258
lime	19	277
shale	6	283
lime	20	303
shale	6	309
lime	4	313
shale	4	317
lime	6 $\frac{1}{2}$	326
shale dark	6	332
shale light	21	353
shale gray sdy	23	376
shale dark	59	435
shale white	62	497
lime	5	502
shale	3	505
lime	4	509
shale dark	5	514

lime	9	523
sand	8	532
shale dark	7 $\frac{1}{2}$	539 $\frac{1}{2}$ T.D.

KANSAS GEOLOGICAL SOCIETY
KANSAS WELL LOG BUREAU - KANSAS WELL SAMPLE BUREAU
KANSAS GEOLOGICAL SOCIETY BUILDING
508 EAST MURDOCK - WICHITA, KANSAS

4-14-22
ORIGINAL

COMPANY

FARM

TOTAL DEPTH 393

COMM.

SHOT OR TREATED**CONTRACTOR**

ISSUED

CASINO

20	10
15	8
12	6
13	5

COMP.


LOG.

BOUNTY

KANSAS

ELEVATION

PRODUCTION

FIGURES INDICATE BOTTOM OF FORMATIONS

Sal 2	
alg 10	
Wood 29	
Lime L	78
Shale /	48
Lime L	60
Shale /	81
Lime L	149
Shale /	90
Lime L	203
Shale /	15
Lime L	23
Shale /	31
Lime L	64
Shale /	70
Lime L	71
Shale /	77
Lime L	306
Lime / shale	12
Lime L	76
Shale /	40

Lime 63 43
 Shale 1 50
 Lime 45 7
 Shale 1 81
 — 90

rsj 93 I.
TD 393