

STATE CORPORATION COMMISSION OF KANSAS
OIL & GAS CONSERVATION DIVISION

WELL COMPLETION OR RECOMPLETION FORM
ACO-1 WELL HISTORY

DESCRIPTION OF WELL AND LEASE

Operator: license # 5561
name Miller Brothers Prod. Co.
address 427 South Parker
City/State/Zip Olathe, KS 66061

Operator Contact Person Scott R. Miller
Phone (913) 782-4133

Contractor: license # 9681
ame Triple E. Drilling Co.

Wellsite Geologist Robert E. Miller
Phone (913) 782-4133

PURCHASER

Type of Completion
☒ New Well ☐ Re-Entry ☐ Workover

☒ Oil ☐ SWD ☐ Temp Abd
☐ Gas ☐ Inj ☐ Delayed Comp.
☒ Dry ☐ Other (Core, Water Supply etc.)

If OWWO: old well info as follows:

Operator
Well Name
Comp. Date Old Total Depth

WELL HISTORY

Drilling Method: ☐ Mud Rotary ☐ Air Rotary ☐ Cable

5-30-85 6-1-85 6-3-85
Sp. te Date Reached TD Completion Date

920'
Total Depth PBTD

At of Surface Pipe Set and Cemented at 25 feet

Multiple Stage Cementing Collar Used? ☐ Yes ☒ No

If Yes, Show Depth Set feet

If alternate 2 completion, cement circulated
from feet depth to w/ SX cmt

API NO. 15 - 091-21,532

County Johnson

E/2 E/2 SW Sec 8 Twp 14S Rge 22
(location) West

1320.. Ft North from Southeast Corner of Section
2805.. Ft West from Southeast Corner of Section
(Note: locate well in section plat below)


Lease Name Andrew Well# 1

Field Name South Kill Creek

Producing Formation

Elevation: Ground KB

Section Plat

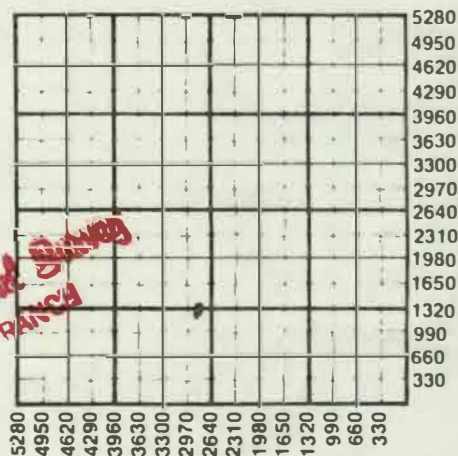

WATER SUPPLY INFORMATION

Source of Water:

Division of Water Resources Permit #

☐ Groundwater. Ft North From Southeast Corner and
(Well) Ft. West From Southeast Corner of
Sec Twp Rge ☐ East ☐ West

☐ Surface Water. Ft North From Southeast Corner and
(Stream, Pond etc.) Ft West From Southeast Corner
Sec Twp Rge ☐ East ☐ West

☐ Other (explain)
(purchased from city, R.W.D.#)

Disposition of Produced Water: ☐ Disposal
☐ Repressuring

Docket #

INSTRUCTIONS: This form shall be completed in duplicate and filed with the Kansas Corporation Commission, 200 Colorado Derby Building, Vichita, Kansas 67202, within 90 days after completion or recompletion of any well. Rules 82-3-130 and 82-3-107 apply.

Information on side two of this form will be held confidential for a period of 12 months if requested in writing and submitted with the form. See rule 82-3-107 confidentiality in excess of 12 months.

copy of all wireline logs and drillers time log shall be attached with this form. Submit CP-4 form with all plugged wells. Submit CP-111 form with temporarily abandoned wells.