

STATE CORPORATION COMMISSION OF KANSAS  
OIL & GAS CONSERVATION DIVISION  
WELL COMPLETION OR RECOMPLETION FORM  
ACO-1 WELL HISTORY  
DESCRIPTION OF WELL AND LEASE

Operator: License # 6142  
Name Town Oil Co.  
Address Rt. 4  
City/State/Zip Paola, Ks. 66071

Purchaser Fairway Crude

Operator Contact Person Lester Town  
Phone 913-294-2125

Contractor: License # 6142  
Name Town Oil Co.

Wellsite Geologist None  
Phone

Designate Type of Completion

☒ New Well ☐ Re-Entry ☐ Workover  
☒ Oil ☐ SWD ☐ Temp Abd  
☐ Gas ☐ Inj ☐ Delayed Comp.  
☐ Dry ☐ Other (Core, Water Supply etc.)

If OWWO: old well info as follows:

Operator  
Well Name  
Comp. Date Old Total Depth

WELL HISTORY

Drilling Method:

☒ Mud Rotary ☐ Air Rotary ☐ Cable

9-19-84 9-24-84 11-8-84  
Spud Date Date Reached TD Completion Date

875 N/A  
Total Depth PBTD

Amount of Surface Pipe Set and Cemented at 20 feet  
Multiple Stage Cementing Collar Used? Yes ☒ No  
If yes, show depth set feet  
If alternate 2 completion, cement circulated  
from 20 feet depth to top w/ 3 SX cmt  
Cement Company Name Town Oil Co.  
Date of First Production Producing Method

11-9-84

☐ Flowing ☒ Pumping ☐ Gas Lift ☐ Other (explain)

| Estimated Production<br>Per 24 Hours | Oil      | Gas       | Water    | Gas-Oil Ratio | Gravity |
|--------------------------------------|----------|-----------|----------|---------------|---------|
|                                      | 1/2 Bbls | Trace MCF | 15% Bbls | CFPB          | 25%     |

API No. 15-091-21,359

County Johnson

SW SW NE Sec. 19 Twp. 14 Rge. 22 ☒ East  
West

2805 2854 FSL; 1990 FEL-KCC record  
2010 Ft North from Southeast Corner of Section  
Ft West from Southeast Corner of Section  
(Note: Locate well in section plat below)


Lease Name Guetterman Well # 3

Field Name Gardner

Producing Formation Bartlesville

Elevation: Ground unknown KB

Section Plat

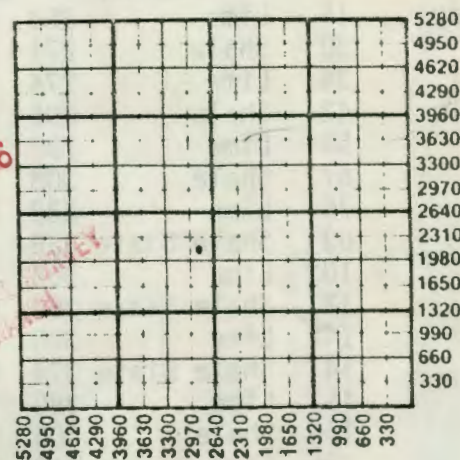

WATER SUPPLY INFORMATION

Disposition of Produced Water: N/A Disposal  
Docket # Repressuring

Questions on this portion of the ACO-1 call:

Water Resources Board (913) 296-3717

Source of Water: N/A

Division of Water Resources Permit #

Groundwater Ft North from Southeast Corner  
(Well) Ft West from Southeast Corner of  
Sec Twp Rge East West

Surface Water Ft North from Southeast Corner  
(Stream, pond etc) Ft West from Southeast Corner  
Sec Twp Rge East West

Other (explain)



366-11-21

SIDE TWO

Operator Name ..... Town Oil Co. .... Lease Name..... Guetterman ..... Well #..... 3 .....

Sec..... 19 ..... Twp..... 14 ..... Rge..... 22 ..... ☒ East ☐ West County..... Johnson .....

WELL LOG

INSTRUCTIONS: Show important tops and base of formations penetrated. Detail all cores. Report all drill stem tests giving interval tested, time tool open and closed, flowing and shut-in pressures, whether shut-in pressure reached static level, hydrostatic pressures, bottom hole temperature, fluid recovery, and flow rates if gas to surface during test. Attach extra sheet if more space is needed. Attach copy of log.

|                                   |     |              |     |                                         |                                        |                                                              |     |       |        |
|-----------------------------------|-----|--------------|-----|-----------------------------------------|----------------------------------------|--------------------------------------------------------------|-----|-------|--------|
| Drill Stem Tests Taken            |     |              |     | <input type="checkbox"/> Yes            | <input checked="" type="checkbox"/> No | Formation Description                                        |     |       |        |
| Samples Sent to Geological Survey |     |              |     | <input type="checkbox"/> Yes            | <input checked="" type="checkbox"/> No | <input type="checkbox"/> Log <input type="checkbox"/> Sample |     |       |        |
| Cores Taken                       |     |              |     | <input checked="" type="checkbox"/> Yes | <input type="checkbox"/> No            |                                                              |     |       |        |
| Soil & Clay                       | 15  | Lime         | 268 | Shale                                   | 551                                    | Name                                                         |     | Top   | Bottom |
| Shale                             | 30  | Shale        | 271 | Lime                                    | 557                                    | Shale                                                        | 708 | Shale | 868    |
| Lime                              | 34  | Lime         | 274 | Shale                                   | 560                                    | Sand                                                         | 716 | Lime  | 869    |
| Sandy Shale                       | 42  | Shale        | 295 | Lime                                    | 561                                    | Sandy Shale                                                  | 735 | Shale | 875    |
| Lime                              | 58  | Lime         | 297 | Shale Shells                            | 563                                    | Slate                                                        | 737 |       |        |
| Shale                             | 67  | Shale        | 308 | Shale                                   | 572                                    | Shale                                                        | 740 |       |        |
| Lime                              | 75  | Lime         | 332 | Lime                                    | 574                                    | Shale Shell                                                  | 742 |       |        |
| Shale                             | 83  | Shale Slate  | 338 | Shale Shells                            | 579                                    | Sandy Shale                                                  | 752 |       |        |
| Lime                              | 102 | Lime         | 362 | Shale                                   | 593                                    | Shale Shells                                                 | 758 |       |        |
| Shale                             | 121 | Shale Slate  | 366 | Lime                                    | 596                                    | Shale                                                        | 767 |       |        |
| Lime                              | 142 | Lime         | 370 | Shale                                   | 597                                    | Shale Shells                                                 | 770 |       |        |
| Shale                             | 147 | Shale Slate  | 374 | Slate                                   | 598                                    | Slate                                                        | 771 |       |        |
| Lime                              | 157 | Lime         | 380 | Shale                                   | 607                                    | Shale                                                        | 774 |       |        |
| Shale                             | 158 | Shale        | 406 | Lime                                    | 609                                    | Sand                                                         | 776 |       |        |
| Lime                              | 195 | Sand         | 413 | Shale                                   | 627                                    | Shale Shells                                                 | 781 |       |        |
| Shale                             | 217 | Sandy Shale  | 507 | Coal                                    | 629                                    | Slate                                                        | 782 |       |        |
| Lime                              | 227 | Shale Shells | 508 | Shale                                   | 631                                    | Shale                                                        | 810 |       |        |
| Shale                             | 237 | Shale        | 516 | Lime                                    | 634                                    | Shale Shells                                                 | 818 |       |        |
| Shale Shells                      | 243 | Shale Shells | 517 | Shale                                   | 636                                    | Shale                                                        | 830 |       |        |
| Lime                              | 248 | Shale        | 531 | Shale Shells                            | 639                                    | Lime Shells                                                  | 832 |       |        |
| Shale                             | 256 | Shale Shells | 535 | Shale                                   | 683                                    | Broken Sand                                                  | 838 |       |        |

|                                                                                     |                                             |                           |                |                                                                     |                |             |                            |
|-------------------------------------------------------------------------------------|---------------------------------------------|---------------------------|----------------|---------------------------------------------------------------------|----------------|-------------|----------------------------|
| CASING RECORD <input checked="" type="checkbox"/> New <input type="checkbox"/> Used |                                             |                           |                |                                                                     |                |             |                            |
| Report all strings set-conductor, surface, intermediate, production, etc.           |                                             |                           |                |                                                                     |                |             |                            |
| Purpose of String                                                                   | Size Hole Drilled                           | Size Casing Set (In O.D.) | Weight Lbs/Ft. | Setting Depth                                                       | Type of Cement | #Sacks Used | Type and Percent Additives |
| ...Surface.....                                                                     | 9"                                          | 6 1/2"                    |                | 20                                                                  | Portland       | 3           |                            |
| ..Production...                                                                     | 5 1/8"                                      | 2 7/8"                    |                | 861                                                                 | Portland       | 91          |                            |
| .....                                                                               |                                             |                           |                |                                                                     |                |             |                            |
| PERFORATION RECORD                                                                  |                                             |                           |                | Acid, Fracture, Shot, Cement Squeeze Record                         |                |             |                            |
| Shots Per Foot                                                                      | Specify Footage of Each Interval Perforated |                           |                | (Amount and Kind of Material Used)                                  |                |             | Depth                      |
| ....2.....                                                                          | R32-R37.....                                |                           |                | 75 bbls Fluid 4000lbs Sand                                          |                |             | 832-837                    |
| .....                                                                               |                                             |                           |                |                                                                     |                |             |                            |
| TUBING RECORD                                                                       |                                             |                           |                |                                                                     |                |             |                            |
| Size                                                                                | Set At                                      | Packer at                 | Liner Run      | <input type="checkbox"/> Yes <input checked="" type="checkbox"/> No |                |             |                            |
| 1"                                                                                  | 826'                                        |                           |                |                                                                     |                |             |                            |