

STATE CORPORATION COMMISSION OF KANSAS
OIL & GAS CONSERVATION DIVISION

WELL COMPLETION OR RECOMPLETION FORM
ACO-1 WELL HISTORY

DESCRIPTION OF WELL AND LEASE

Operator: license # .9203.....
nameRolex, Inc.....
address932 Massachusetts.....
City/State/ZipLawrence, Kansas...66046

Operator Contact Person .Pat.Haley.....
Phone (.213)..456-8823.....

Contractor: license # ...5304.....
nameGault Energy Corp.....

Wellsite GeologistPat.Haley.....
Phone(213)..456-8823.....

PURCHASEREnron.....

Designate Type of Completion

☒ New Well ☐ Re-Entry ☐ Workover

☒ Oil ☐ SWD ☐ Temp Abd
☐ Gas ☐ Inj ☐ Delayed Comp.
☐ Dry ☐ Other (Core, Water Supply etc.)

If ~~W~~WO: old well info as follows:

Operator
Well Name
Comp. Date Old Total Depth

WELL HISTORY

Drilling Method: ☐ Mud Rotary ☒ Air Rotary ☐ Cable

3-14-85 3-19-85 4-5-85
Spud Date Date Reached TD Completion Date

1109 ft. K.L.
Total Depth PBTD

Amount of Surface Pipe Set and Cemented at20 feet

Multiple Stage Cementing Collar Used? ☐ Yes ☒ No

If Yes, Show Depth Set feet

If alternate 2 completion, cement circulated
from Surface.. feet depth to20' w/10. SX cmt

API NO. 15 - .091-21,483.....

County Johnson.....

NE NW NE Sec 22 Twp 14 Rge 22 X East
(location) West

5,115 Ft North from Southeast Corner of Section

1,485 Ft West from Southeast Corner of Section

(Note: locate well in section plat below)


Lease Name GILLIHAN Well# D-1

Field Name Gardner

Producing Formation Bartlesville

Elevation: Ground 1,012' KB

Section Plat

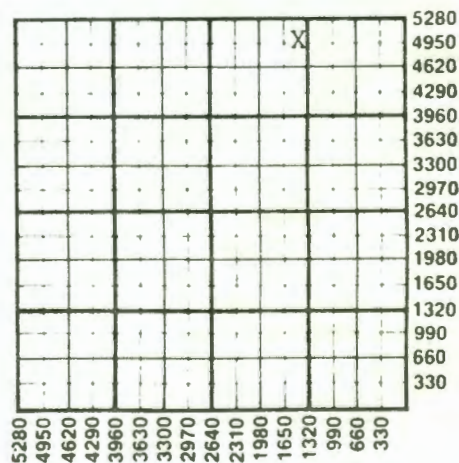

WATER SUPPLY INFORMATION

Source of Water:

Division of Water Resources Permit #

☐ Groundwater..... Ft North From Southeast Corner and
(Well) Ft. West From Southeast Corner of
Sec Twp Rge ☐ East ☐ West

☐ Surface Water..... Ft North From Southeast Corner and
(Stream, Pond etc.) Ft West From Southeast Corner
Sec Twp Rge ☐ East ☐ West

☐ Other (explain)
(purchased from city, R.W.D.#)

Disposition of Produced Water: ☐ Disposal
☐ Repressuring

Docket #

INSTRUCTIONS: This form shall be completed in duplicate and filed with the Kansas Corporation Commission, 200 Colorado Derby Building, Wichita, Kansas 67202, within 90 days after completion or recompletion of any well. Rules 82-3-130 and 82-3-107 apply.

Information on side two of this form will be held confidential for a period of 12 months if requested in writing and submitted with the form. See rule 82-3-107 for confidentiality in excess of 12 months.

SIDE TWO

Operator Name Rolex, Inc. Lease Name Gillihan Well# D-1 SEC 22 TWP 14 RGE 22 ☒ East ☐ West

WELL LOG

INSTRUCTIONS: Show important tops and base of formations penetrated. Detail all cores. Report all drill stem tests giving interval tested, time tool open and closed, flowing and shut-in pressures, whether shut-in pressure reached static level, hydrostatic pressures, bottom hole temperature, fluid recovery, and flow rates if gas to surface during test. Attach extra sheet if more space is needed. Attach copy of log.

Drill Stem Tests Taken
Samples Sent to Geological Survey
Cores Taken

☐ Yes ☒ No
☐ Yes ☒ No
☐ Yes ☒ No

Formation Description
☒ Log ☐ Sample

Name	Top	Bottom
Kansas City		370
Cherokee	633	
Bartlesville	823	

TUBING RECORD

size set at packer at

Liner Run ☐ Yes ☒ No

Date of First Production
4/6/85

Producing method

☐ flowing ☒ pumping ☐ gas lift ☐ Other (explain)

Estimated Production
Per 24 Hours

Oil

Gas

Water

Gas-Oil Ratio

Gravity

2 Bbls

0 MCF

0 Bbls

CFPB

22

METHOD OF COMPLETION

PRODUCTION INTERVAL

Disposition of gas: ☐ vented
☐ sold
☐ used on lease

☐ open hole ☒ perforation
☐ other (specify)

Bartlesville 823-829

☐ Dually Completed.
☐ Commingled

CASING RECORD

☒ new ☐ used

Report all strings set - conductor, surface, intermediate, production, etc.

Purpose of string	size hole drilled	size casing set (in O.D.)	weight lbs/ft.	setting depth	type of cement	# sacks used	type and percent additives
Surface Production	10 1/4" 6 1/2"	7" 2 7/8"	16 1/2	20 871'	Portland 50/50 POZ	10 155	

PERFORATION RECORD

Acid, Fracture, Shot, Cement Squeeze Record

shots per foot specify footage of each interval perforated

(amount and kind of material used)

Depth

2

823-25 & 827-829'

95 bbls gelled water & 50 sacks of sand