

STATE CORPORATION COMMISSION OF KANSAS
OIL & GAS CONSERVATION DIVISION
WELL COMPLETION OR RECOMPLETION FORM
ACO-1 WELL HISTORY
DESCRIPTION OF WELL AND LEASE

Operator: License # 9511
Name Alternative Energy Systems, Inc.
Address 508 W. Washington
PO Box 306
City/State/Zip Cuba, Mo. 65453

Purchaser Enron Oil Trading & Trans
PO Box 20108
Shreveport, La. 71120

Operator Contact Person Michael L. Giles
Phone 314-885-2838

Contractor: License # 5335
Name Hawkeve Drilling

Wellsite Geologist Bob Fieller
Phone 913-883-2013

Designate Type of Completion

☒ New Well ☐ Re-Entry ☐ Workover
☐ Oil ☐ SWD ☐ Temp Abd
☐ Gas ☒ Inj ☐ Delayed Comp.
☐ Dry ☐ Other (Core, Water Supply etc.)

If ONWO: old well info as follows:

Operator
Well Name
Comp. Date Old Total Depth

WELL HISTORY

Drilling Method:

☒ Mud Rotary ☐ Air Rotary ☐ Cable

8/16/89 8/31/89 12/8/89
Spud Date Date Reached TD Completion Date

960 956
Total Depth PBTD

Amount of Surface Pipe Set and Cemented at 20 feet
Multiple Stage Cementing Collar Used? Yes ☒ No

If yes, show depth set.....feet
If alternate 2 completion, cement circulated
from 956 feet depth to surface 102 SX cmt
Cement Company Name Consolidated
Invoice # 001004322

API NO. 15-...091-22-086

County Johnson

..S.. E... Sec. 28.. Twp. 14.. Rge. 22.. ☒ East
West

1875
1115 Ft North from Southeast Corner of Section
Ft West from Southeast Corner of Section

(Note: Locate well in section plat below)


Lease Name Meyers 16A
Well #

Field Name Bears and Bulls

Producing Formation Bartlesville

Elevation: Ground 1076 3.5 KB

Section Plat

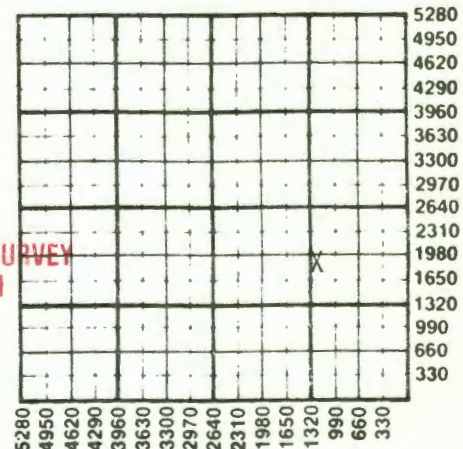

KANSAS GEOLOGICAL SURVEY
WICHITA BRANCH

WATER SUPPLY INFORMATION

Disposition of Produced Water: Disposal
Docket # ☒ Repressuring

Questions on this portion of the ACO-1 call:

Water Resources Board (913) 296-3717

Source of Water:

Division of Water Resources Permit #

Groundwater.....Ft North from Southeast Corner
(Well)Ft West from Southeast Corner of
Sec Twp Rge East West

Surface Water.....Ft North from Southeast Corner
(Stream, pond etc).....Ft West from Southeast Corner
Sec Twp Rge East West

Other (explain).....
(purchased from city, R.W.D. #)

INSTRUCTIONS: This form shall be completed in triplicate and filed with the Kansas Corporation Commission, 200 Colorado Derby Building, Wichita, Kansas 67202, within 120 days of the spud date of any well. Rule 82-3-130, 82-3-107 and 82-3-106 apply.

Information on side two of this form will be held confidential for a period of 12 months if requested in writing and submitted with the form. See rule 82-3-107 for confidentiality in excess of 12 months. One copy of all wireline logs and drillers time log shall be attached with this form. Submit CPA form with

Operator Name Alternative Energy Systems, Inc. Lease Name Meyers Well # 16A

Sec. 28 Twp. 14 Rge. 22 ☒ East ☐ West County Johnson

WELL LOG

INSTRUCTIONS: Show important tops and base of formations penetrated. Detail all cores. Report all drill stem tests giving interval tested, time tool open and closed, flowing and shut-in pressures, whether shut-in pressure reached static level, hydrostatic pressures, bottom hole temperature, fluid recovery, and flow rates if gas to surface during test. Attach extra sheet if more space is needed. Attach copy of log.

Drill Stem Tests Taken ☐ Yes ☒ No
 Samples Sent to Geological Survey ☐ Yes ☒ No
 Cores Taken ☐ Yes ☒ No

Formation Description
☒ Log ☐ Sample

Name	Top	Bottom
Hertha	417	427
Bartlesville	902	916

CASING RECORD ☐ New ☒ Used

Report all strings set-conductor, surface, intermediate, production, etc.

Purpose of String	Size Hole Drilled	Size Casing Set (in O.D.)	Weight Lbs/Ft.	Setting Depth	Type of Cement	#Sacks Used	Type and Percent Additives
Surface	8 7/8	7		20	Portland	10	None
Production	6	2 7/8	6	956	Oil Well	102	Gel

PERFORATION RECORD

Shots Per Foot	Specify Footage of Each Interval Perforated	Acid, Fracture, Shot, Cement Squeeze Record (Amount and Kind of Material Used)	Depth
2	904-912	Water	

TUBING RECORD	Size	Set At	Packer at	Liner Run	☐ Yes ☐ No
---------------	------	--------	-----------	-----------	--

Date of First Production _____ Producing Method ☐ Flowing ☐ Pumping ☐ Gas Lift ☐ Other (explain) _____

HAWKEYE DRILLING

R.R. 2 Box 73A
Wellsville, Kansas 66092
913-883-2013

28-14-22E

955.0

Lease

Meyers

Well #

#16A 8-16-89

Elevation

15-091-22,086

1 2 3 4 5 6 7 8 9 10
|||||

Drill Log

Thickness	Formation	Total Depth	Remarks	Thickness	Formation	Total Depth	Remarks
18	CLAY	18		5	Shale	652	
4	Lime	22		5	Lime	657	
8	Shale	30		5	Shale	662	
2	Lime	32		3	Lime	665	
22	Shale	54		15	Shale	680	
28	Lime	82		5	Lime	685	
10	Shale	92		12	Shale	697	
7	Lime	99		2	Lime	699	
10	Shale	109		10	Shale	709	
21	Lime	130		2	Lime	711	
16	Shale	146		88	Shale	799	
20	Lime	166		5	Lime	804	
11	Shale	177		25	Shale	829	
6	Lime	183		4	BlackShale	833	
16	Shale	199		1	Lime	834	
3	Lime	202		15	Shale	849	
8	Shale	210		1	Lime	850	
18	Lime	228		35	Shale	885	
20	Shale	248		1	Lime	886	
16	Lime	264		4	SAND	890	
2	Shale	266		65	Shale	955 TD	
2	Lime	268					
21	Shale	289					
8	Lime	297					
3	Shale	300					
10	Lime	310					
47	Shale	357					
3	Lime	360					
8	Shale	368					
21	Lime	389					
1	Shale	390					
4	Lime	394					
8	Shale	402					
12	Lime	414					
3	Shale	417					
10	Lime	427					
148	Shale	575					
4	Lime	579					
18	Shale	597					
6	Lime	603					
2	Shale	605					
4	Lime	609					
6	Shale	615					
8	Lime	623					
5	Shale	628					
4	Lime	632					
1	Shale	633					
4	Lime	637					

KANSAS GEOLOGICAL SURVEY
WICHITA BRANCH

RECEIVED
STATE CORPORATION COMMISSION

DEC 22 1989

CONSERVATION DIVISION
Wichita, Kansas

CASING MECHANICAL INTEGRITY TEST

DOCKET # E 24,883Disposal ☐ Enhanced Recovery: _____Repressuring ☐Flood ☐Tertiary ☐

Date injection started _____

API #15 - 071 - 22,086Lease W. H. MyersCounty JohnsonWell # 16 AOperator: HIT Energy

Name & _____

Address PO Box 304Cuba, Mo.Operator License # 9511Contact Person Mike Giles

Phone _____

Max. Auth. Injection Press. _____ psi; Max. Inj. Rate _____ bbl/d;
 If Dual Completion - Injection above production _____ Injection below production _____

Conductor	Surface	Production	Liner	Size	Tubing
Size _____	<u>4"</u>	<u>2 7/8</u>	_____	_____	_____
Set at _____	<u>20</u>	<u>956</u>	_____	Set at _____	_____
Cement Top _____	<u>0</u>	<u>0</u>	_____	Type _____	_____
" Bottom _____	<u>20</u>	<u>956</u>	_____	_____	_____
DV/Perf. _____	TD (and plug back) _____	<u>960</u>	_____	ft. depth _____	_____
Packer type _____	Size _____	Set at _____	_____	_____	_____
Zone of injection <u>886</u>	ft. to ft. <u>895</u>	Perf. or open hole <u>perf.</u>	_____	_____	_____

Type Mit: Pressure ☒ Radioactive Tracer Survey ☐ Temperature Survey ☐F Time: Start 10 Min. 20 Min. 30 Min.

I _____

E Pressures: 600 600 600 Set up 1 System Pres. during test _____L 600 lb Set up 2 Annular Pres. during test _____D _____ Set up 3 Fluid loss during test 0 bbls.

D _____

A _____

T Tested: Casing ☒ or Casing - Tubing Annulus ☐

A _____

The bottom of the tested zone is shut in with float shoeTest Date 9-12-89 Using Consolidated Company's Equipment

The operator hereby certifies that the zone between _____ feet and _____ feet

was the zone tested Robert Fichter Reiller

Signature

Title

The results were Satisfactory ☒, Marginal _____, Not Satisfactory _____State Agent Jack Kobi Title P. H. H. Witness: Yes ☒ No _____

REMARKS: _____

☐ Origin. Conservation Div.; ☐ KDHE/T; ☐ Dist. Office;☐ Computer Update

KCC Form U-7 6/84