

COPY

SIDE ONE

STATE CORPORATION COMMISSION OF KANSAS
OIL & GAS CONSERVATION DIVISION
WELL COMPLETION FORM
ACO-1 WELL HISTORY
DESCRIPTION OF WELL AND LEASE

Operator: License # 7622Name: Richard L. RobertsAddress P.O. Box 421City/State/Zip Olathe, Kansas 66061Purchaser: EnronOperator Contact Person: Richard L. RobertsPhone (913) 782-0623Contractor: Name: Van Drilling, Inc.License: 4423Wellsite Geologist: None

Designate Type of Completion

☒ New Well ☐ Re-Entry ☐ Workover STATE CORPORATION COMMISSION
☒ Oil ☐ SWD ☐ Temp. Abd.
☐ Gas ☐ Inj ☐ Delayed Comp.
☐ Dry ☐ Other (Core, Water Supply, etc.)

If ~~OLD~~: old well info as follows:

Operator: _____

Well Name: _____

Comp. Date _____ Old Total Depth _____

Drilling Method:

☒ Mud Rotary ☐ Air Rotary ☐ Cable

6-5-90 6-8-90 8-11-90
Spud Date Date Reached TD Completion Date

API NO. 15- 091-22-191County Johnson

3a NW NE NW Sec. 29 Twp. 14 Rge. 22 ☒ East
West

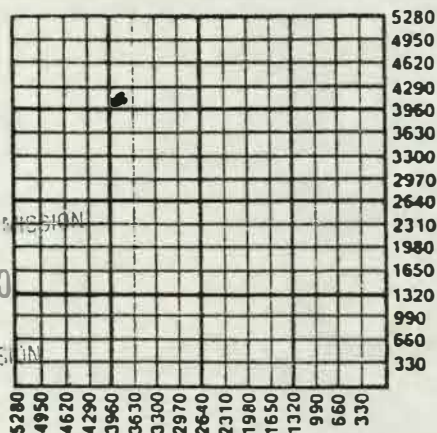
3985 3973 FSL Ft. North from Southeast Corner of Section

3640 3502 FEL Ft. West from Southeast Corner of Section

(2010-Red Dragon NOTE: Locate well in section plat below.)

Lease Name Bacon Well # 27Field Name Longanecker SoutheastProducing Formation Bartlesville

Elevation: Ground _____ KB _____

Total Depth 910 PBTD 891

RECEIVED

AUG 30 1990

CONSERVATION DIVISION
Wichita, Kansas

8-30-90

Amount of Surface Pipe Set and Cemented at 40 Feet:Multiple Stage Cementing Collar Used? ☐ Yes ☒ No

If yes, show depth set _____ Feet

If Alternate II completion, cement circulated from 0feet depth to 40' 906 w/ 20 135 sx -mt.

INSTRUCTIONS: This form shall be completed in triplicate and filed with the Kansas Corporation Commission, 200 Colorado Derby Building, Wichita, Kansas 67202, within 120 days of the spud date of any well. Rule 82-3-130, 82-3-107 and 82-3-106 apply. Information on side two of this form will be held confidential for a period of 12 months if requested in writing and submitted with the form. See rule 82-3-107 for confidentiality in excess of 12 months. One copy of all wireline logs and drillers time log shall be attached with this form. ALL CEMENTING TICKETS MUST BE ATTACHED. Submit CP-1 form with all plugged wells. Submit CP-111 form with all temporarily abandoned wells. Any recompletion, workover or conversion of a well requires filing of ACO-2 within 120 days from commencement date of such work.

All requirements of the statutes, rules and regulations promulgated to regulate the oil and gas industry have been fully complied with and the statements herein are complete and correct to the best of my knowledge.

Signature

Richard L. RobertsTitle OperatorDate 8-22-90

scribed and sworn to before me this 22 day of August
90.

Notary Public

Cindy Lynn Walters

Date Commission Expires _____

CINDY LYNN WALTERS
NOTARY PUBLIC
STATE OF KANSAS
My App't Expires 7-13-94

K.C.C. OFFICE USE ONLY

F ☐ Letter of Confidentiality Attached
C ☒ Wireline Log Received
C ☐ Drillers Timelog Received

Distribution

☒ KCC ☐ SWD/Rep ☒ NGPA
☒ KGS ☐ Plug ☐ Other
(Specify)

IOG/SOC

Form ACO-1 (7-89)

SIDE TWO

Operator Name Richard L. Roberts Lease Name Bacon Well # 27
 Sec. 29 Twp. 14 Rge. 22 ☒ East ☐ West
 County Johnson

INSTRUCTIONS: Show important tops and base of formations penetrated. Detail all cores. Report all drill stem tests giving interval tested, time tool open and closed, flowing and shut-in pressures, whether shut-in pressure reached static level, hydrostatic pressures, bottom hole temperature, fluid recovery, and flow rates if gas to surface during test. Attach extra sheet if more space is needed. Attach copy of log.

Drill Stem Tests Taken ☐ Yes ☒ No (Attach Additional Sheets.) Samples Sent to Geological Survey ☐ Yes ☒ No Cores Taken (dropped) ☐ Yes ☒ No Electric Log Run ☒ Yes ☐ No (Submit Copy.)	<table border="1" style="width: 100%; border-collapse: collapse;"> <tr> <th colspan="3">Formation Description</th> </tr> <tr> <td></td> <td style="text-align: center;">☒ Log</td> <td style="text-align: center;">☐ Sample</td> </tr> <tr> <th style="text-align: left;">Name</th> <th style="text-align: center;">Top</th> <th style="text-align: center;">Bottom</th> </tr> <tr> <td>Surface</td> <td style="text-align: center;">0</td> <td style="text-align: center;">24</td> </tr> <tr> <td>Base KC Line</td> <td></td> <td style="text-align: center;">377</td> </tr> <tr> <td>Hertha</td> <td style="text-align: center;">382</td> <td style="text-align: center;">392</td> </tr> <tr> <td>Big Shale</td> <td style="text-align: center;">389</td> <td style="text-align: center;">569</td> </tr> <tr> <td>Ft. Scott</td> <td style="text-align: center;">569</td> <td style="text-align: center;">620</td> </tr> <tr> <td>Cherokee Section</td> <td style="text-align: center;">619</td> <td style="text-align: center;">826</td> </tr> <tr> <td>(Bartlesville)</td> <td style="text-align: center;">843</td> <td style="text-align: center;">851</td> </tr> <tr> <td>TD</td> <td style="text-align: center;">891</td> <td></td> </tr> </table>	Formation Description				☒ Log	☐ Sample	Name	Top	Bottom	Surface	0	24	Base KC Line		377	Hertha	382	392	Big Shale	389	569	Ft. Scott	569	620	Cherokee Section	619	826	(Bartlesville)	843	851	TD	891	
Formation Description																																		
	☒ Log	☐ Sample																																
Name	Top	Bottom																																
Surface	0	24																																
Base KC Line		377																																
Hertha	382	392																																
Big Shale	389	569																																
Ft. Scott	569	620																																
Cherokee Section	619	826																																
(Bartlesville)	843	851																																
TD	891																																	

CASING RECORD

☐ New ☒ Used

Report all strings set-conductor, surface, intermediate, production, etc.

Purpose of String	Size Hole Drilled	Size Casing Set (In O.D.)	Weight Lbs./Ft.	Setting Depth	Type of Cement	# Sacks Used	Type and Percent Additives
Production	5 1/8	2 7/8	5	891	Portland	135	Flo-seal
Surface	7"	7"	16	40'	Portland	20	

Shots Per Foot	PERFORATION RECORD Specify Footage of Each Interval Perforated	Acid, Fracture, Shot, Cement Squeeze Record (Amount and Kind of Material Used)	Depth
9 holes	843 to 851	10 sk 12x30 sand	843
		30 ska 10x20 sand	to
		4 ska Rock salt	851
		1 sk water gel	
		3 gal. Ay 15	
		100 gal. Acid 15%	

TUBING RECORD		Size	Set At	Packer At	Liner Run	☐ Yes ☒ No
		2 7/8	891			
Date of First Production	Producing Method ☐ Flowing ☒ Pumping ☐ Gas Lift ☐ Other (Explain)					
8-12-90						
Estimated Production Per 24 Hours	Oil Bbls.	Gas Mcf	Water Bbls.	Gas-Oil Ratio	Gravity	
	10	TSTM	10	TSTM	24°	

Disposition of Gas:

METHOD OF COMPLETION

Production Inter:

☐ Vented ☐ Sold ☒ Used on Lease
 (If vented, submit ACO-18.)

☐ Open Hole ☒ Perforation ☐ Dually Completed ☐ Commingled
☐ Other (Specify) _____

STATION Olathe OPERATOR R. R.

CONSOLIDATED OIL WELL SERVICES, INC.

P.O. Box 884
Chanute, Kansas 66720
Phone (316) 431-921029-14-22E
Ticket 78991

COPY

Date	Customer's Acct. No.	Sec.	Twp.	Range	Well No. & Farm	Place or Destination
2/11/90	2032	29	14	22	#20 Bacon	Gardner
Charge To	Richard Roberts			Owner	County	
Mailing Address	P.O. Box 421			Contractor	State	
City & State	Olathe, Ks. 66061			Well Owner Operator Contractor	Ks.	

CEMENTING SERVICE DATA

TYPE OF JOB	CASING	HOLE DATA	PLUGS AND HEAD	PRESSURE	CEMENT LEFT IN CASING
Surface	New	Bore Size	Bottom	Circulating	Requested
Production	Used	Total Depth	Top	Minimum	Necessity
Squeeze	Size		Head	Maximum	Measured
Pumping	Weight	Cable Tool	FLOAT EQUIPMENT		Sacks Cement
Other	Depth	Rotary			Type & Brand
	Type				Admixes

Handwritten notes: 5-11, 910, 5-W, 200, 200, 600, 135, Portion of 54031, 270 gal 32.5% H₂O, F10-Seal

FRACTURING - ACIDIZING SERVICE DATA

Type of Job	At Intervals of
Bbls Fracturing Fluid	Breakdown Pressure from
Treating Pressures: Maximum	psi
Sand	Gals. Treat hg Acid
Wk	ing Through: Tubing
	Casing
	Annulus
	Size
	Weight

Handwritten notes: hole size variations, GPM/BPM, Close In

CEMENTING *Cement One Well*

INVOICE SECTION

FRACTURING - ACIDIZING

Pumping Charge	Office Use	Pumping Charge	Office Use
135 Sacks Bulk Cement @ 5.25	1101	708.75	
Ton Mileage on Bulk Cement 35 @	6.40	52.00	
4 Premium Gel @ 6.90	1301	27.60	
1.5 Flo-Seal @ 30.00	1302	30.00	
Calcium Chloride @			
1-2 1/2" Plug Rubber @ 7.00	4403	7.00	
1.5 Cotton Seed Hulls @ 9.00	1104	9.00	
Equipment @			
2 gal Mucall (35% @)			
200# Granulated Salt @ .12	1305	24.00	
1 port Truck (Hrs.) @			
Vac Truck (3 Hrs.) @	620	132.00	
Tax		42.86	
Total		\$1412.21	

Handwritten notes: 5401, 380.00, 12x30 Sand, 10x20 Sand, x Sand, Ton Mileage, Gals., Acid, Chemicals, NOTE: Had to wait for Rig to run pipe. D@ to surface washed out took app. 400 extra cement, ran F10-Seal & Cotton Seed hulls in cement to keep circulation, got cement. Potassium Chloride @ Surface, Rock Salt @, Water Gel @, Transport Truck (Hrs.) @, Vac Truck (Hrs.) @, Thank you for business.

A Finance Charge computed at 14% per month (annual percentage rate of 21%) will be added to balance over 30 days.

Total \$1412.21

Total \$

110983 We Appreciate

VAN DRILLING INC.
P.O. BOX 296
EASMON, KS. 66020

29 14-22E
API# 15-091-22,191
T.D. 910'

COPY

LOG BOOK COPY

LEGALS: SEC 29, TWP 14S, RGE 22E
WELL OWNER: RICHARD ROBERTS
WELL NO: #27
FARM: BACON
STATE: KS

REMARKS: SEE RMKS BELOW

<u>THICKNESS OF STRATA</u>	<u>FORMATION</u>	<u>TOTAL DEPTH</u>
24	surface	24
17	shale	41
4	lime	45
4	shale	49
16	lime	65
10	shale	75
9	lime	84
6	shale	90
10	lime	100
3	shale	103
7	lime	110
16	shale	126
20	lime	146
2	shale	148
2	lime	150
6	shale	156
51	lime	207
20	shale	227
9	lime	236
17	shale	253
6	lime	259
6	shale	265
9	lime	274
29	shale	303
2	lime	305
10	shale	315
31	lime	346
4	shale	350
26	lime	376
2	shale	378
4	lime	382
4	shale	386
6	lime	392
4	shale	396
2	lime	398
171	shale	569
5	lime	574
27	shale	601
4	lime	605
6	shale	611
9	lime	620
23	shale	643
3	lime	646
40	shale	686
23	sandy shale	709
2	lime	711
25	sandy shale	736
10	shale	746
3	coal	749
75	shale	824
4	lime	828
2	shale	830
15	lime	845
0	cored lost core	859
51	shale	910'

REMARKS: BASE KC LINE 377'
HERTHA 382'-392'
BIG SHALE 389'-569'
FT SCOTT 569'-620'
OHEROKEE SECTION 619'-826'
CORED 842'-851'
T.D. 891'