

COPY

SIDE ONE

STATE CORPORATION COMMISSION OF KANSAS
OIL & GAS CONSERVATION DIVISION
WELL COMPLETION FORM
ACO-1 WELL HISTORY
DESCRIPTION OF WELL AND LEASE

KCC
RecordOperator: License # 7622Name: Richard L. RobertsAddress P.O. Box 421City/State/Zip Olathe, Kansas 66061Purchaser: EnronOperator Contact Person: Richard L. RobertsPhone (913) 782-0623Contractor: Name: Van Drilling, Inc.License: 4423Wellsite Geologist: None

Designate Type of Completion

☒ New Well ☐ Re-Entry ☐ Workover☒ Oil ☐ SWD ☐ Temp. Abd.☐ Gas ☐ Inj ☐ Delayed Comp.☐ Dry ☐ Other (Core, Water Supply, etc.)If OWO: old well info as follows:

Operator: _____

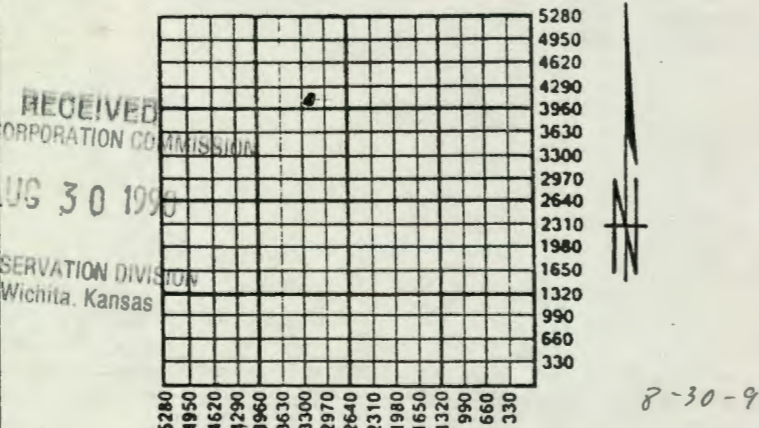
Well Name: _____

Comp. Date _____ Old Total Depth _____

Drilling Method:

☒ Mud Rotary ☐ Air Rotary ☐ Cable
6-11-90 6-13-90 8-11-90
Spud Date Date Reached TD Completion Date
API NO. 15- 091-22-192County Johnson
S2 SW NE
NW NW Sec. 29 Twp. 14 Rge. 22 ☒ East ☐ West
3986 3941 FSL Ft. North from Southeast Corner of Section3200 3054 FEL Ft. West from Southeast Corner of SectionKCC Record → 2010-Red Dragon Oil / 2017 DRAGONSLAYERLease Name Bacon Well # 28Field Name Longanecker SoutheastProducing Formation Bartlesville

Elevation: Ground _____ KB _____

Total Depth 891 PBD 890Amount of Surface Pipe Set and Cemented at 40 Feet:Multiple Stage Cementing Collar Used? ☐ Yes ☒ No

If yes, show depth set _____ Feet

If Alternate II completion, cement circulated from 0feet depth to 40 824 w/ 20 106 sx -mt.

INSTRUCTIONS: This form shall be completed in triplicate and filed with the Kansas Corporation Commission, 200 Colorado Derby Building, Wichita, Kansas 67202, within 120 days of the spud date of any well. Rule 82-3-130, 82-3-107 and 82-3-106 apply. Information on side two of this form will be held confidential for a period of 12 months if requested in writing and submitted with the form. See rule 82-3-107 for confidentiality in excess of 12 months. One copy of all wireline logs and drillers time log shall be attached with this form. ALL CEMENTING TICKETS MUST BE ATTACHED. Submit CP-4 form with all plugged wells. Submit CP-111 form with all temporarily abandoned wells. Any recompletion, workover or conversion of a well requires filing of ACO-2 within 120 days from commencement date of such work.

All requirements of the statutes, rules and regulations promulgated to regulate the oil and gas industry have been fully complied with and the statements herein are complete and correct to the best of my knowledge.

Signature Richard L. RobertsTitle Operator Date 8-22-90Subscribed and sworn to before me this 22 day of August, 90.Notary Public Cindy Lynn Walters

Date Commission Expires _____

CINDY LYNN WALTERS
NOTARY PUBLIC
STATE OF KANSAS
My App't Expires 7-13-94

K.C.C. OFFICE USE ONLY

F ☐ Letter of Confidentiality Attached
C ☒ Wireline Log Received
C ☐ Drillers Timelog Received

Distribution

☒ KCC ☐ SWD/Rep ☒ NGPA
☒ KGS ☐ Plug ☐ Other
(Specify)

106150C

Form ACO-1 (7-89)

SIDE TWO

Operator Name Richard L. Roberts Lease Name Bacon Well # 28
 Sec. 29 Twp. 14 Rge. 22 ☒ East ☐ West
 County Johnson

INSTRUCTIONS: Show important tops and base of formations penetrated. Detail all cores. Report all drill stem tests giving interval tested, time tool open and closed, flowing and shut-in pressures, whether shut-in pressure reached static level, hydrostatic pressures, bottom hole temperature, fluid recovery, and flow rates if gas to surface during test. Attach extra sheet if more space is needed. Attach copy of log.

Drill Stem Tests Taken ☐ Yes ☒ No
 (Attach Additional Sheets.)
 Samples Sent to Geological Survey ☐ Yes ☒ No
 Cores Taken ☒ Yes ☐ No
 Electric Log Run ☒ Yes ☐ No
 (Submit Copy.)

Formation Description

☒ Log ☐ Sample

Name	Top	Bottom
KC Line		
Hertha	384	391
Big Shale	391	580
Cherokee Section	618	842
Bartlesville	841	847
TD	891	

CASING RECORD

☐ New ☒ Used

Report all strings set-conductor, surface, intermediate, production, etc.

Purpose of String	Size Hole Drilled	Size Casing Set (In O.D.)	Weight Lbs./Ft.	Setting Depth	Type of Cement	# Sacks Used	Type and Percent Additives
Production	5 1/8	2 7/8	5	890	Portland	106	Flo-Seal
Surface	7	7	1	40	Portland	20	Gel

PERFORATION RECORD

Shots Per Foot Specify Footage of Each Interval Perforated

Acid, Fracture, Shot, Cement Squeeze Record (Amount and Kind of Material Used) Depth

9 Holes	841 to 847	10 sk 12x30 sand	841
841 to 847		20 sk 10x20 sand	to
		100 gal. add 15%	847
9"		2 gal. Av 15	
		1 sk water gel 50 lbs.	

TUBING RECORD

Size Set At Packer At
 2 7/8 890

Liner Run ☐ Yes ☒ No

Date of First Production 8-12-90	Producing Method ☐ Flowing ☒ Pumping ☐ Gas Lift ☐ Other (Explain)	Estimated Production Per 24 Hours	Oil Bbls. 10	Gas Mcf TSTM	Water Bbls. 10	Gas-Oil Ratio TSTM	Gravity 24°
-------------------------------------	--	-----------------------------------	-----------------	-----------------	-------------------	-----------------------	----------------

Disposition of Gas:

METHOD OF COMPLETION

Production Interval

☐ Vented ☐ Sold ☒ Used on Lease
 (If vented, submit ACO-18.)

☐ Open Hole ☒ Perforation ☐ Dually Completed ☐ Commingled
☐ Other (Specify) _____

VAN DRILLING INC.
P.O BOX 296
EASTON, KS. 66020

29-14-22E
API# 15-091-22,192
T.D. 891'

COPY

LOG BOOK COPY

LEGALS: SEC 29, TWP 14S, RGE 22E
WELL OWNER: RICHARD ROBERTS
WELL NO: #28
FARM: BACON
STATE: KS

REMARKS: SEE RMKS BELOW

<u>THICKNESS OF STRATA</u>	<u>FORMATION</u>	<u>TOTAL DEPTH</u>
43	surface	43
3	lime	46
2	shale	48
17	lime	65
10	shale	75
8	lime	83
6	shale	89
10	lime	99
3	shale	102
7	lime	109
15	shale	124
25	lime	149
4	shale	153
53	lime	206
18	shale	224
12	lime	236
16	shale	252
5	lime	257
8	shale	265
9	lime	274
30	shale	304
3	lime	307
9	shale	316
8	lime	324
1	shale	325
17	lime	342
6	shale	348
23	lime	371
3	shale	374
6	lime	380
4	shale	384
7	lime	391
169	shale	560
12	lime	572
6	shale	578
10	lime	588
12	shale	600
3	lime	603
4	shale	607
11	lime	618
29	shale	647
1	lime	648
200	shale	748
3	lime	751
91	shale	842
9	sand	851
40	shale	891'

REMARKS: BASE KC LINE 380'
HERTHA 384' - 391'
BIG SHALE 391' - 560'
FT SCOTT 560' - 618'
CHEROKEE SECTION 618' - 842'
CORED 842' - 851'
T.D. 891'