

1

STATE CORPORATION COMMISSION OF KANSAS
OIL & GAS CONSERVATION DIVISION

WELL COMPLETION OR RECOMPLETION FORM
ACO-1 WELL HISTORY

DESCRIPTION OF WELL AND LEASE

Operator: License # 8653
Name Petroleum Technologies, Inc.
Address 3535 Broadway, Suite C
City/State/Zip Kansas City, MO 64111

Purchaser Amoco

Operator Contact Person Alan J. Seaton
Phone (816) 531 6904

Contractor: License # 9003
Name Central Plains Oil and Gas

Wellsite Geologist N/A
Phone

Designate Type of Completion
 New Well Re-Entry Workover
 Oil SWD Temp Abd
 Gas Inj Delayed Comp.
 Dry Other (Core, Water Supply etc.)

If OWO: old well info as follows:
Operator
Well Name
Comp. Date Old Total Depth.....

WELL HISTORY

Drilling Method:
 Mud Rotary Air Rotary Cable
2-4-85 2-7-85 6-6-85
.....
Spud Date Date Reached TD Completion Date
.....
..... N/A

Amount of Surface Pipe Set and Cemented at 20 feet
Multiple Stage Cementing Collar Used? Yes No
If yes, show depth set.....feet
If alternate 2 completion, cement circulated
from 930 feet depth to Surface 110 SX cmt

API NO. 15-091-21,450
County Johnson
SE NE NW SW Sec. 32 Twp. 14S Rge. 22 East West

4613 PSL; 4096 FGL - KCC records
3135 Ft North from Southeast Corner of Section
4125 Ft West from Southeast Corner of Section


(Note: Locate well in section plat below)
2010; Knabe (32-7 - KCC records
Lease Name Knabe Well # 32-7

Field Name N/A

Producing Formation Cherokee Group

Elevation: Ground N/A KB N/A

Section Plat

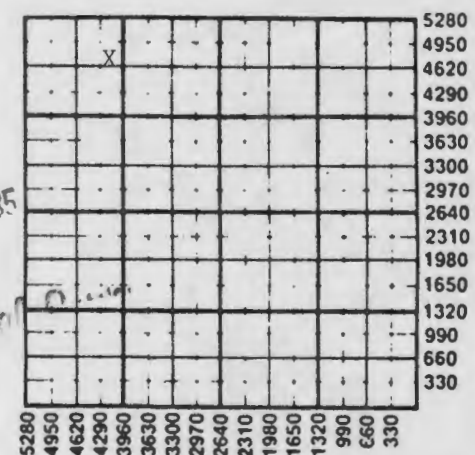

AUG 26 1985
State Geologist
WICHITA

WATER SUPPLY INFORMATION

Disposition of Produced Water: Disposal Repressuring
Docket #

Questions on this portion of the ACO-1 call:
Water Resources Board (913) 296-3717

Source of Water:
Division of Water Resources Permit #.....
 Groundwater.....Ft North from Southeast Corner (Well)Ft West from Southeast Corner of Sec Twp Rge East West
 Surface Water.....Ft North from Southeast Corner (Stream, pond etc).....Ft West from Southeast Corner Sec Twp Rge East West
 Other (explain).....
(purchased from city, R.W.D. #)

INSTRUCTIONS: This form shall be completed in duplicate and filed with the Kansas Corporation Commission, 200 Colorado Derby Building, Wichita, Kansas 67202, within 90 days after completion or recompletion of any well. Rule 82-3-130 and 82-3-107 apply.
Information on side two of this form will be held confidential for a period of 12 months if requested in writing and submitted with the form. See rule 82-3-107 for confidentiality in excess of 12 months.
One copy of all wireline logs and drillers time log shall be attached with this form. Submit CP-4 form with all plugged wells. Submit CP-111 form with all temporarily abandoned wells.