

STATE CORPORATION COMMISSION OF KANSAS
OIL & GAS CONSERVATION DIVISION

WELL COMPLETION OR RECOMPLETION FORM
ACO-1 WELL HISTORY

DESCRIPTION OF WELL AND LEASE

Operator: License # 8653
Name Petroleum Technologies, Inc.
Address 3535 Broadway, Suite C
City/State/Zip Kansas City, MO 64111

Purchaser Amoco

Operator Contact Person Alan J. Seaton
Phone (816) 531 6904

Contractor: License # 9003
Name Central Plains Oil and Gas

Wellsite Geologist N/A
Phone

Designate Type of Completion

☒ New Well ☐ Re-Entry ☐ Workover

☒ Oil ☐ SWD ☐ Temp Abd
☐ Gas ☐ Inj ☐ Delayed Comp.
☐ Dry ☐ Other (Core, Water Supply etc.)

If ONWO: old well info as follows:

Operator
Well Name
Comp. Date Old Total Depth

WELL HISTORY

Drilling Method:

☐ Mud Rotary ☒ Air Rotary ☐ Cable

1-26-85 1-30-85 6-6-85
Spud Date Date Reached TD Completion Date
950 N/A
Total Depth PBTD

Amount of Surface Pipe Set and Cemented at 20 feet
Multiple Stage Cementing Collar Used? ☐ Yes ☒ No
If yes, show depth set.....feet
If alternate 2 completion, cement circulated
from 927 feet depth to Surface 110 SX cmt

API NO. 15-091-21-445

County Johnson

SE NE NE NW 32 Twp 14S Rge 22 ☒ East ☐ West

4808 FSL 2767 FEL-KCC record
4785 Ft North from Southeast Corner of Section
2805 Ft West from Southeast Corner of Section

(Note: Locate well in section plat below)


Lease Name Knabe 2010: Knabe C 32-15-KCC record
Well # 32-15

Field Name N/A

Producing Formation Cherokee Group

Elevation: Ground N/A KB N/A

Section Plat

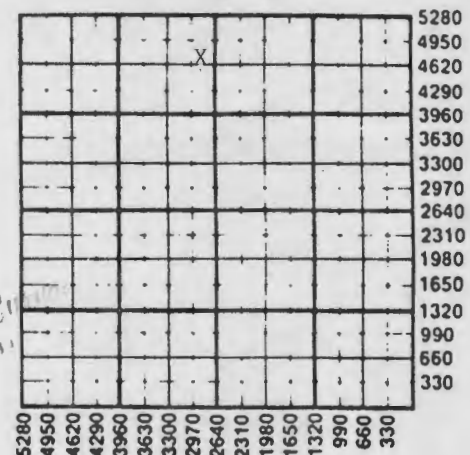

WATER SUPPLY INFORMATION

Disposition of Produced Water: ☐ Disposal
Docket # ☐ Repressuring

Questions on this portion of the ACO-1 call:

Water Resources Board (913) 296-3717

Source of Water:

Division of Water Resources Permit #

☐ Groundwater.....Ft North from Southeast Corner
(Well)Ft West from Southeast Corner of
Sec Twp Rge ☐ East ☐ West

☐ Surface Water.....Ft North from Southeast Corner
(Stream, pond etc).....Ft West from Southeast Corner
Sec Twp Rge ☐ East ☐ West

☐ Other (explain).....
(purchased from city, R.W.D. #)

INSTRUCTIONS: This form shall be completed in duplicate and filed with the Kansas Corporation Commission, 200 Colorado Derby Building, Wichita, Kansas 67202, within 90 days after completion or recompletion of any well. Rule 82-3-130 and 82-3-107 apply.
Information on side two of this form will be held confidential for a period of 12 months if requested in writing and submitted with the form. See rule 82-3-107 for confidentiality in excess of 12 months.
One copy of all wireline logs and drillers time log shall be attached with this form. Submit CP-4 form with all plugged wells. Submit CP-111 form with all temporarily abandoned wells.