

STATE CORPORATION COMMISSION OF KANSAS
OIL & GAS CONSERVATION DIVISION
WELL COMPLETION OR RECOMPLETION FORM
ACO-1 WELL HISTORY
DESCRIPTION OF WELL AND LEASE

Operator: License # 8369
Name Dale George/Wm. Voigts Jr.
Address 32175 W 183rd St
City/State/Zip Gardner, Ks 66030

Purchaser Amoco

Operator Contact Person Wm. Voigts Jr.
Phone 913-884-7753

Contractor: License # 9545
Name K.O. Drilling

Wellsite Geologist None
Phone

Designate Type of Completion

☒ New Well ☐ Re-Entry ☐ Workover
☒ Oil ☐ SWD ☐ Temp Abd
☐ Gas ☐ Inj ☐ Delayed Comp.
☐ Dry ☐ Other (Core, Water Supply etc.)

If OMWO: old well info as follows:

Operator
Well Name
Comp. Date Old Total Depth

WELL HISTORY

Drilling Method:

☒ Mud Rotary ☐ Air Rotary ☐ Cable
8-16-84 8-16-84 10-2-84
Spud Date Date Reached TD Completion Date

910 N/A
Total Depth PBTD

Amount of Surface Pipe Set and Cemented at 41 feet
Multiple Stage Cementing Collar Used? Yes ☒ No
If yes, show depth set feet
If alternate 2 completion, cement circulated
from 41 feet depth to top 10 SX cmt
Cement Company Name K.O. Drilling
Invoice #

API NO. 15-091-21,321

County Johnson

NW NW SE Sec 33 Twp 14 Rge 22 East West

2040 2140
Ft North from Southeast Corner of Section
Ft West from Southeast Corner of Section

(Note: Locate well in section plat below)


Lease Name Henrich Well # 2

Field Name Gardner

Producing Formation Bartlesville

Elevation: Ground None KB

Section Plat

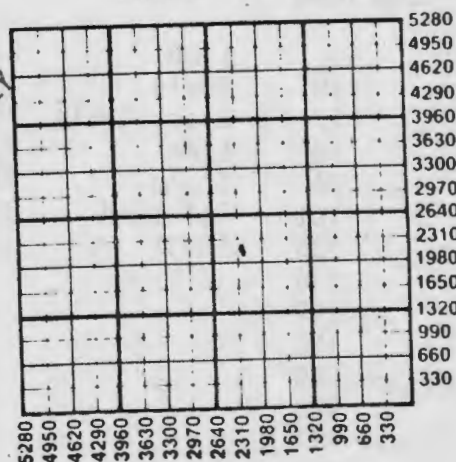

WATER SUPPLY INFORMATION

Disposition of Produced Water: N/A Disposal
Docket # Repressuring

Questions on this portion of the ACO-1 call:

Water Resources Board (913) 296-3717

Source of Water: N/A

Division of Water Resources Permit #

Groundwater.....Ft North from Southeast Corner
(Well)Ft West from Southeast Corner of
Sec Twp Rge East West

Surface Water.....Ft North from Southeast Corner
(Stream, pond etc).....Ft West from Southeast Corner
Sec Twp Rge East West

Other (explain).....
(purchased from city, R.W.D. #)

INSTRUCTIONS: This form shall be completed in duplicate and filed with the Kansas Corporation Commission, 200 Colorado Derby Building, Wichita, Kansas 67202, within 90 days after completion or recompletion of any well. Rule 82-3-130 and 82-3-107 apply.

Information on side two of this form will be held confidential for a period of 12 months if requested in writing and submitted with the form. See rule 82-3-107 for confidentiality in excess of 12 months.

One copy of all wireline logs and drillers time log shall be attached with this form. Submit CP-4 form with all plugged wells. Submit CP-111 form with all temporarily abandoned wells.

SIDE TWO

Operator Name Dale George/Wm Voigts Jr. Lease Name Henrich Well # 2

Sec <u>33</u>	Twp <u>14</u>	Rang <u>22</u>	☒ East ☐ West	County <u>Johnson</u>
Oil	Gas	Water	Gas-Oil Ratio	Gravity
Estimated Production Per 24 Hours	1 Bbls	trace MCF	5% Bbls	CFPB 21

METHOD OF COMPLETION

Production Interval

Disposition of gas: ☐ Vented☐ Open Hole☒ Perforation

Drill Stem Tests Taken

☐ Yes☒ No

Samples Sent to Geological Survey

☐ Yes☒ No

Cores Taken

☒ Yes☐ No

Formation Description

☐ Log☐ Sample

Name

Top

Bottom

Soil	3	Lime	633
Lime	10	Shale	715
Shale	17	Black Shale	720
Lime	54	Lime	724
Shale	74	Shale	813
Lime	101	Oil Sand	829
Shale	126	Shale	910
Lime	136		
Shale	167		
Lime	192		
Shale	209		
Lime	228		
Shale	277		
Lime	351		
Shale	528		
Lime	541		
Sandy Shale	596		
Red Bed	608		
Grey Shale	624		
Black Shale	628		

CASING RECORD

☒ New☐ Used

Report all strings set-conductor, surface, intermediate, production, etc.

Purpose of String	Size Hole Drilled	Size Casing Set (in O.D.)	Weight Lbs/Ft.	Setting Depth	Type of Cement	#Sacks Used	Type and Percent Additives
Surface	9"	7"		41	Portland	10	
Production	5 1/4"	2 7/8"		910	Portland	97	

PERFORATION RECORD

Acid, Fracture, Shot, Cement Squeeze Record

Shots Per Foot	Specify Footage of Each Interval Perforated	(Amount and Kind of Material Used)	Depth
3.0	816.0-821.0	120 bbls water gel 40 sk sand	816-821

TUBING RECORD	Size 1"	Set At 887.5	Packer at	Liner Run	☐ Yes ☒ No
Date of First Production	Producing Method				
☐ Flowing ☒ Pumping ☐ Gas Lift ☐ Other (explain).....					