

STATE CORPORATION COMMISSION OF KANSAS
OIL & GAS CONSERVATION DIVISIONWELL COMPLETION OR RECOMPLETION FORM
ACO-1 WELL HISTORY

DESCRIPTION OF WELL AND LEASE

Operator: License # 8369
 Name Dale George/ Wm Voigts Jr.
 Address 32175 W 183rd St
 City/State/Zip Gardner, Ks. 66030

Purchaser Amoco

Operator Contact Person Wm Voigts Jr.
 Phone 913-884-7753

Contractor: License # 9545
 Name K.O. Drilling

Wellsite Geologist none
 Phone

Designate Type of Completion

☒ New Well ☐ Re-Entry ☐ Workover

☒ Oil ☐ SWD ☐ Temp Abd
☐ Gas ☐ Inj ☐ Delayed Comp.
☐ Dry ☐ Other (Core, Water Supply etc.)

If OWWO: old well info as follows:

Operator
 Well Name
 Comp. Date Old Total Depth

WELL HISTORY

Drilling Method:

☒ Mud Rotary ☐ Air Rotary ☐ Cable

10-3-84 10-4-84 10-23-84
 Spud Date Date Reached TD Completion Date
 910 N/A
 Total Depth PBTD

Amount of Surface Pipe Set and Cemented at 41.7 feet
 Multiple Stage Cementing Collar Used? ☐ Yes ☒ No
 If yes, show depth set feet
 If alternate 2 completion, cement circulated
 from 41.7 feet depth to top w/.6 SX cmt

API NO. 15-091-21,375

County Johnson

NE SW NE ☒ East
 Sec 33 Twp 14 Rge 22 ☐ West

1265 Ft North from Southeast Corner of Section
 1200 Ft West from Southeast Corner of Section

(Note: Locate well in section plat below)


Lease Name Voigts Well # 5

Field Name Gardner

Producing Formation Bartlesville

Elevation: Ground unknown KB

Section Plat

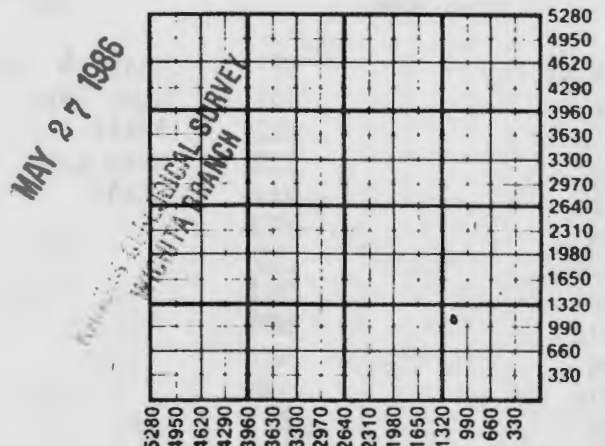

WATER SUPPLY INFORMATION

Disposition of Produced Water: N/A ☐ Disposal
 Docket # ☐ Repressuring

Questions on this portion of the ACO-1 call:

Water Resources Board (913) 296-3717

Force of Water: N/A

Division of Water Resources Permit #

☐ Groundwater Ft North from Southeast Corner
 (Well) Ft West from Southeast Corner of
 Sec Twp Rge ☐ East ☐ West

☐ Surface Water Ft North from Southeast Corner
 (Stream, pond etc) Ft West from Southeast Corner
 Sec Twp Rge ☐ East ☐ West

☐ Other (explain)
 (purchased from city, R.W.D. #)

INSTRUCTIONS: This form shall be completed in duplicate and filed with the Kansas Corporation Commission, 200 Colorado Derby Building, Wichita, Kansas 67202, within 90 days after completion or recompletion of any well. Rule 82-3-130 and 82-3-107 apply.

Information on side two of this form will be held confidential for a period of 12 months if requested in writing and submitted with the form. See rule 82-3-107 for confidentiality in excess of 12 months.

One copy of all wireline logs and drillers time log shall be attached with this form. Submit CP-4 form with Sublet CP-111 form with all temporarily abandoned wells.

SIDE TWO

Operator Name Dale George/Wm Voigts Jr. Lease Name Voigts Well # 5

Sec. 33 Twp. 14 Rge. 22 ☒ East ☐ West County Johnson

Date of First Production <u>10-24-84</u>	Producing Method ☐ Flowing ☒ Pumping ☐ Gas Lift ☐ Other (explain).....				
Estimated Production Per 24 Hours	Oil 1 Bbls	Gas trace MCF	Water 5% Bbls	Gas-Oil Ratio CFPB	Gravity 21

Drill Stem Tests Taken ☐ Yes ☒ No
 Samples Sent to Geological Survey ☐ Yes ☒ No
 Cores Taken ☒ Yes ☐ No

Formation Description
☐ Log ☐ Sample

Soil & Clay	18	Shale & Sandy Shale	834
Lime	161	Lime Cap	837
Shale	202	Shale	848
Lime	218	Hard Cap	860
Shale	241	Shale	910
Lime	259		
Shale	307		
Lime	383		
Shale	554		
Lime	581		
Shale	598		
Lime	617		
Red Bed	629		
Shale	651		
Cap Rock	652		
Sand & Sandy Shale	664		
Shale	742		
Lime	744		
Shale	752		
Lime	754		

Name Top Bottom

CASING RECORD ☒ New ☐ Used							
Report all strings set-conductor, surface, intermediate, production, etc.							
Purpose of String	Size Hole Drilled	Size Casing Set (in O.D.)	Weight Lbs/Ft.	Setting Depth	Type of Cement	#Sacks Used	Type and Percent Additives
Surface	9"	6 5/8		41.7	Portland	6	
Production	5 1/4	2 7/8		910	Portland	97	

PERFORATION RECORD		Acid, Fracture, Shot, Cement Squeeze Record (Amount and Kind of Material Used)	
Shots Per Foot	Specify Footage of Each Interval Perforated		Depth
3.6	853.0-858.0	20 bbls water gel 40 sk sand	853-8

METHOD OF COMPLETION

Production Interval

Disposition of gas: ☐ Vented☐ Open Hole☒ Perforation

TUBING RECORD	Size 1"	Set At 899'	Packer at	Liner Run	☐ Yes ☒ No
---------------	------------	----------------	-----------	-----------	---