

GEOLOGICAL DEPARTMENT  
 UNION GAS CORPORATION  
 INDEPENDENCE, KANSAS

11-14-23E

Company B. Earl Smith, et al.

S. T. R. 11-14-23  
 County Johnson  
 State Kansas  
 Lease and Well No. Will Jameson #1

Contractor B. Earl Smith

Drilling Commenced 11/9/36      Drilling Completed 11/14/36


Initial Production Dry hole      Initial Rock Pressure

Location 710' E and 120' N. of SW corner NW $\frac{1}{4}$

Casing 2,785 FSL ; 4,579 FEL

SE SW NW

↑  
 KGS-DRL NAD83  
 LEO web 03/08/23

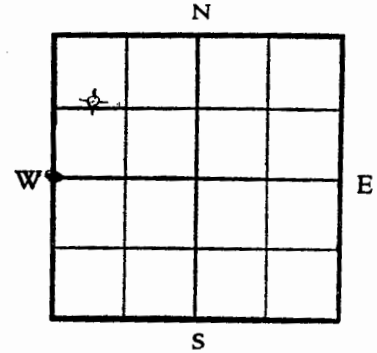

Driller's Record of Formations

soil	3	3	
yellow clay	7	10	
sand stone	3	13	
lime	22	35	
shale black	8	43	
lime	7	50	
shale light	8	58	
lime	14	72	
shale light	18	90	
lime	14	104	
shale blue	11	115	
lime	21	136	
shale	52	188	
lime-	15	203	
shale blue	20	223	
lime	6	229	
shale	3	232	
lime	10	242	
shale blue	35	277	
lime	3	280	
shale dark	10	290	
lime	23	313	
shale dark	6	319	
lime	1	320	
shaledark	3	323	
lime	20	343	
shale black	4	347	
lime	3	350	
shale dark	8	356	
lime	6	362	S.L.M.
shale	2	364	
shale white	10	374	
shale	28	400	
shale dark blue	15	415	Bottom of hole

No showing of gas. No sand at all.