

WELL COMPLETION REPORT AND DRILLER'S LOG

State Geological Survey
KANSAS
 WICHITA BRANCH

S. 33 T. 14 R. 25 E. XV

API No. 15 — Johnson — 15-091-20, 331
 County Number

Loc. 25' FNL 75' FEL
 1295 FSL 75' SE SE
 County Johnson

Operator
 PEGLO Inc.

Address
 Stillwell, Kansas


Well No. 1 Lease Name Harvey Hilt NE NE SE SE *KCC record*

Footage Location 25' FNL 75' FEL SE ES 1295 FSL 75' FEL
 feet from (N) (S) line feet from (E) (W) line

Principal Contractor Blue Valley Drilling Geologist

Spud Date 06-29-81 Date Completed 07-07-81 Total Depth 690' P.B.T.D.

Directional Deviation Oil and/or Gas Purchaser

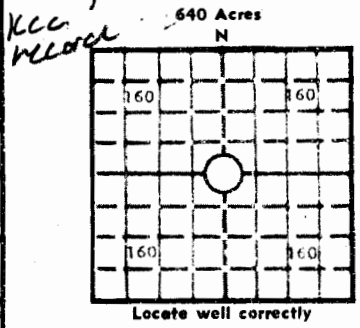

Elev.: Gr. _____
 DF _____ KB _____

CASING RECORD

Report of all strings set — surface, intermediate, production, etc.

Purpose of string	Size hole drilled	Size casing set (in O.D.)	Weight lbs/ft.	Setting depth	Type cement	Sacks	Type and percent additives
Surface	6 1/2"	6 1/2"		30'			

LINER RECORD

PERFORATION RECORD

Top, ft.	Bottom, ft.	Sacks cement	Shots per ft.	Size & type	Depth interval

TUBING RECORD

Size	Setting depth	Packer set at
4"	666'	

ACID, FRACTURE, SHOT, CEMENT SQUEEZE RECORD

Amount and kind of material used	Depth interval treated

INITIAL PRODUCTION

Date of first production _____ Producing method (flowing, pumping, gas lift, etc.) _____

RATE OF PRODUCTION PER 24 HOURS	Oil	Gas	Water	Gas-oil ratio
	bbis.	MCF	bbis.	CFPB

Disposition of gas (vented, used on lease or sold) _____ Producing interval(s) _____

INSTRUCTIONS: As provided in KCC Rule 82-2-125, within 90 days after completion of a well, one completed copy of this Drillers Log shall be transmitted to the State Geological Survey of Kansas, 4150 Monroe Street, Wichita, Kansas 67209. Copies of this form are available from the Conservation Division, State Corporation Commission, 245 No. Water, Wichita, Kansas 67202. Phone AC 316-522-2206. If confidential custody is desired, please note Rule 82-2-125. Drillers Logs will be on open file in the Oil and Gas Division, State Geological Survey of Kansas, Lawrence, Kansas 66044.

Operator		DESIGNATE TYPE OF COMP.: OIL, GAS, DRY HOLE, SWDW, ETC.:
Well No. 1	Lease Name Harvey Hilt	Oil
S <u>33</u> T <u>14</u> R <u>25</u> E		25' FNL 75' FEL SE SE

WELL LOG

Show all important zones of porosity and contents thereof; cored intervals, and all drill-stem tests, including depth interval tested, cushion used, time tool open, flowing and shut-in pressures, and recoveries.

SHOW GEOLOGICAL MARKERS, LOGS RUN, OR OTHER DESCRIPTIVE INFORMATION.

FORMATION DESCRIPTION, CONTENTS, ETC.	TOP	BOTTOM	NAME	DEPTH
Top soil	0	2		
Brown clay	2	8		
Limestone	8	38		
Shale	38	40		
Limestone	40	41		
Shale	41	44		
Shale & limestone layers	44	61		
Limestone	51	78		
Shale	78	101½		
Limestone	101½	111		
Shale	111	115		
Limestone	115	116		
Shale	116	141		
Limestone	141	147		
Shale	147	177		
Limestone	177	183		
Shale	183	186		
Shaley limestone	186	192		
Shale	192	193		
Limestone	193	194		
Shale	194	204		
Limestone	204	207		
Shale	207	209		
Limestone	209	213		
Shale	213	214		
Limestone	214	217		
Shale	217	218		
Limestone	218	228		
Shale	228	229		
Limestone	229	230		
Shale	230	238		
Limestone	238	258		
Shale	258	260		
Slate	260	262		
Limestone	262	265		
Shale	265	269		
Limestone	269	276		
Shale	276	389		

"Continued"

USE ADDITIONAL SHEETS, IF NECESSARY, TO COMPLETE WELL RECORD.

Date Received	_____ Signature _____ Title _____ Date
---------------	---