


MAP NO. KANSAS SEC. 33 TWP. 14S R. 3E

WELL NO. 1 JB Mackay Jr COMPANY

CONTRACTOR

SECTION PLAT

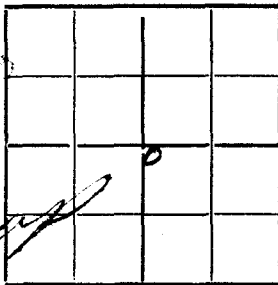

_____ Ft. FROM N. LINE

_____ Ft. FROM S. LINE

_____ Ft. FROM E. LINE

_____ Ft. FROM W. LINE

LOCATION _____

RIG UP _____

DRILLING AND REMARKS:

RECORD
CASED _____ IN. _____ FT.

SAND _____

GAS _____

OIL _____

TOTAL DEPTH 2808 1/2

PRODUCTION

1ST 24 HRS. NAT. _____

1ST 24 HRS. AFTER SHOT _____

GAS _____ CU. Ft.

DRY HOLE ✓

ABANDONED ✓

DATE May 3 1920

SCOUT

Map No. KANSAS Sec. _____ Twp. _____ R. _____


Well No. _____ Farm _____
Company _____

_____ Ft. from N. Line

_____ Ft. from S. Line

_____ Ft. from E. Line

_____ Ft. from W. Line

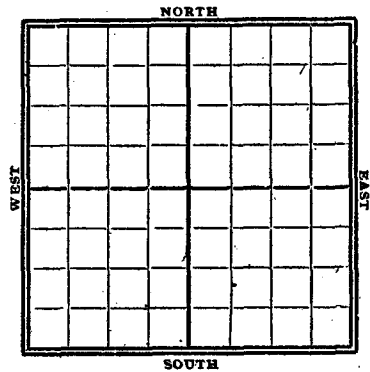

1920

Date

5/3

REPORT

Gypsy Records

Abd. T.D. 2808 1/2

Form 51-5M-4-27-27423

Map No. KANSAS Sec. 33 Twp. 14^S R. 3^E

Well No. J. B. Larsson Farm

J. B. Markey Jr. Company

NORTH

[illegible]