


County **Dickinson** State **Kansas**
 Sec. **34** (Blk. Twp.) **14** (Sur. Rge.) **3E** Map No.
 Operator **Sterling Drlg. etal.**
 Well No. **1** Farm **Hill**

Elev. Location **NW NE NW**

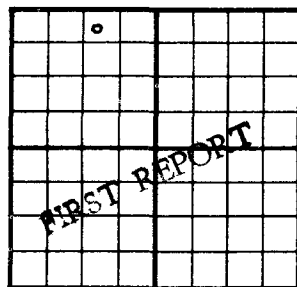

330 Ft. From **N** Line **NW**

990 Ft. From **E** Line Quarter

1st. Report **JAN 2 1952**

Completion

Remarks **Continental farmout**

Slusser Drlg. - Contr.


Spudding Date

Drlg. Data **Wildcat**

Location

J. E. TYRA

County **Dickinson** State **Kansas**
 Sec. **34** (Blk. Twp.) **14** (Sur. Rge.) **3E** Map No.
 Operator **Sterling Drlg. etal.**
 Well No. **1** Farm **Hill**
 Elev. **1356** Location **NW NE NW**

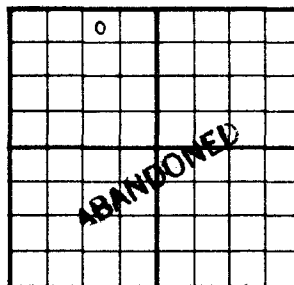

330 Ft. From **N** Line **NW**

990 Ft. From **E** Line Quarter

1st. Report

Completion **JAN 3 1952**

Remarks **Wildcat**

Slusser Drlg. - Contr.

Spudding Date

Drlg. Data **D & A TD 2365**

8" @ 125 KC 1783 Miss. 2392

Dol. 2365 TD 2365

D & A

J. G. McGEHEE

Dickinson

KANSAS

Sec. 34 Twp. 14 R. 3E

Well No. #1 Hill Farm

Sterling Drlg. et al Company

Slusser Drlg. Contractor

Wildcat


330 Ft. from N. Line

Ft. from S. Line

990

Ft. from E. Line

Ft. from W. Line

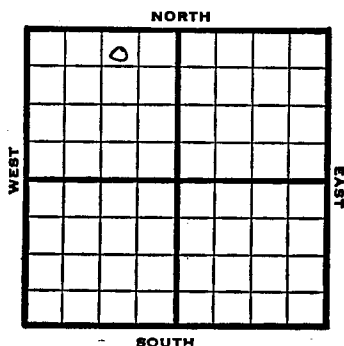

NW NE NW

Continental FO

1952 Elev. 1356 REPORT

1/2 Location

1/30 D&A TD 2365
8" @ 125
kc 1783 Miss. 2392
Dol. 2355 TD 2365
D&A

ABANDONED

15-041-00031

Section 34 Township 14 Range 3E

Well No. #1 Hill

Company Sterling Drlg. et al

