


MAP No. _____ SEC. 6 TWP. N5 R. 4EWELL No. 1 DrillerForster et al COMPANYCONTRACTOR
No wall map

SECTION PLAT

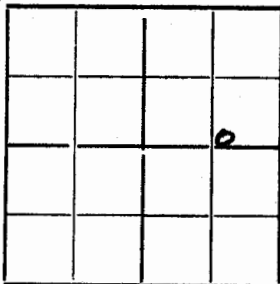

_____ Ft. FROM N. LINE

_____ Ft. FROM S. LINE

_____ Ft. FROM E. LINE

_____ Ft. FROM W. LINE

LOCATION _____

RIG UP _____

DRILLING AND REMARKS:

RECORD

CASED _____ IN. _____ FT.

SAND _____

GAS _____

OIL _____

TOTAL DEPTH 285

PRODUCTION

1ST 24 HRS. NAT. _____

1ST 24 HRS. AFTER SHOT _____

GAS _____ CU. FT.

DRY HOLE ☒ABANDONED ☒

DATE

7/15 1920 _____ SCOUT

Map No. _____ Sec. _____ Twp. _____ R. _____

Well No. _____ Farm


_____ Company

_____ Ft. from N. Line

_____ Ft. from S. Line

_____ Ft. from E. Line

_____ Ft. from W. Line

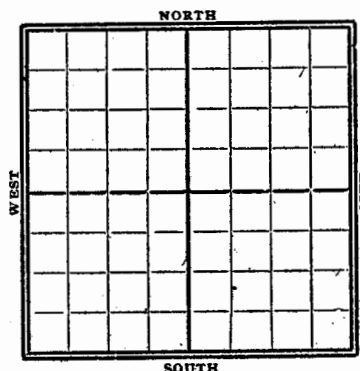

Date

REPORT

1920
Gypsy Records
7/15 Abd T.D. 2985'

TEST

EAST

Location.....
Drilling Remarks

Rig Up.....
Drilling Remarks

RECORD

Cased.....in.....ft.
Sand.....
Gas.....
Oil.....
Total Depth.....

PRODUCTION

1st 24 hrs. Nat.....
1st 24 hrs. after shot.....
Gas..... cu. ft.....
Dry Hole.....
Abandoned.....