

FORM 262-B Dickinson ✓
KANSAS

Sec. 29 Twp. 14 R. 4E

Well No. #1 Foster Farm

Lotus Oil Company Company

Slusser Drlg. - Contr. Contractor


Wildcat

Ft. from N. Line

990 Ft. from S. Line

990 Ft. from E. Line

Ft. from W. Line

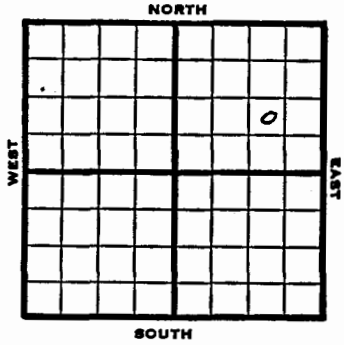

NW SE NE

^{L&S}
1953 Elev. - 1280 REPORT

3/4 Spudded 2/15/53
8" @ 99 Drlg. 1556


3/11 Spud 2-15-53 D & A TD 2170
8" @ 99 Top. 1157 Heeb 1446-50
Tor. 4158-69 Lans 1630 Miss 2156
DST 2156-70 open 1/2 hr. rec 150' wtr.
390# TD 2170
D & A
ABANDONED

FORM 51 Dickinson ¹⁵⁻⁰⁴¹⁻⁰⁰⁰⁰⁴ **KANSAS**

Section 29 Township 14 Range 4E

Well No. #1 Foster

Company Lotus Oil Company

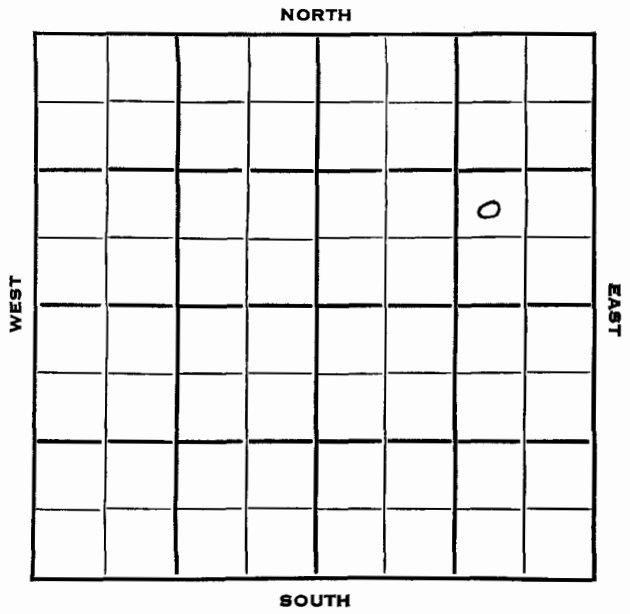

elev 1280 L&S.