


MAP No. _____ SEC. 35 TWP. 14S R. 4EWELL No. 1 MilletteSturck-Messmore COMPANY

CONTRACTOR

SECTION PLAT

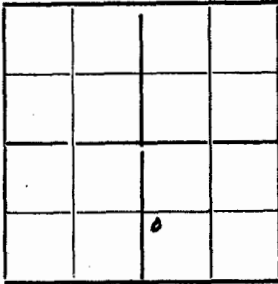

_____ Ft. FROM N. LINE

_____ Ft. FROM S. LINE

_____ Ft. FROM E. LINE

_____ Ft. FROM W. LINE

LOCATION _____

RIG UP _____

DRILLING AND REMARKS:

RECORD

CASED _____ IN. _____ FT.

SAND _____

GAS _____

OIL _____

TOTAL DEPTH 2975

PRODUCTION

1ST 24 HRS. NAT. _____

1ST 24 HRS. AFTER SHOT _____

GAS _____ CU. FT.

DRY HOLE ☒ABANDONED ☒

DATE

4/1 1920 _____ SCOUT

Map No. _____ Sec. _____ Twp. _____ R. _____

Well No. _____ Farm _____


Company _____

_____ Ft. from N. Line

_____ Ft. from S. Line

_____ Ft. from E. Line

_____ Ft. from W. Line

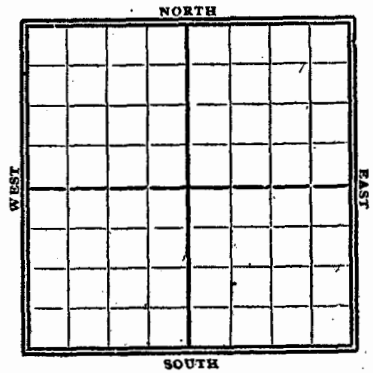

Date

REPORT

1920
4/1Gypsy Records
Abd T.D. 2925'

WEST

EAST

[illegible]

Cased.....in.....ft.	1st 24 hrs. Nat.....
Sand.....	1st 24 hrs. after shot.....
Gas.....	Gas.....cu. ft.....
Oil.....	Dry Hole.....
Total Depth.....	Abandoned.....