

County State Kansas

Sec. 17 (Twp.) 14 (Sur. Rge.) 7E Map No.

Operator Continental Oil

Well No. 1 Farm Anderson

Elev. Location NW NE NW

0				

FIRST REPORT

330 Ft. From N Line NW

990 Ft. From E Line Quarter

1st. Report FEB 4 1953

Completion

Remarks Continental - Contr.

Spudding Date 2-1-53

Drig. Data Wildcat

J. G. McGEHEE

County State Kansas

Sec. 17 (Blk. Twp.) 14 (Sur. Rge.) 7E Map No.

Operator Continental Oil

Well No. 1 Farm Anderson

Elev. 1452 Location NW NE NW

0				

ABANDONED

330 Ft. From N Line NW

990 Ft. From E Line Quarter

1st. Report

Completion FEB 18 1953

Remarks Wildcat

Continental - Contr.

Spudding Date 2-1-53

Drig. Data D & A TD 2856

8" @ 216 Heeb. 1360 Lans. 1563

KC 1669 B KC 1876 Miss. 2069

Kh. 2126 Hunton 2326 Maq. 2524

Viola 2607 Simp. 2774 Arb. 2803

TD 2856

D & A

J. G. McGEHEE

Morris KANSAS ✓

Sec. 17 Twp. 14 R. 7 EWell No. # 1 Anderson Farm

Continental Oil Company

Continental Contractor

Wildcat


330 Ft. from N. Line

Ft. from S. Line

990 Ft. from E. Line

Ft. from W. Line

NW NE NW

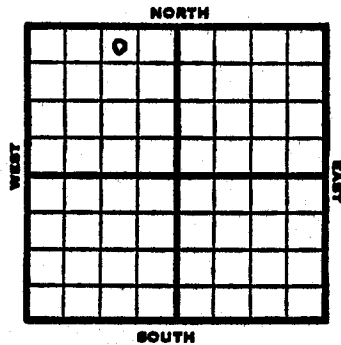

1953 Elev. 1452 REPORT

2/4 Spud 2-1-53
 2/18 Spudding Date 2/1/53
 D&A TD 2856
 8" @ 216 Heeb. 1360 Lans. 1563
 KC 1669 B KC 1876 Mils. 2069
 Kh. 2126 Hunton 2326 Maq. 2524
 Viola 2607 Simp. 2774 Arb. 2803
 TD 2856
 D&A

ABANDONED

$$\begin{array}{r} 1452 \\ 1360 \\ \hline 92 \end{array}$$

$$\begin{array}{r} 1563 \\ 1462 \\ \hline 101 \end{array}$$

$$\begin{array}{r} 1876 \\ 1452 \\ \hline 424 \end{array}$$

$$\begin{array}{r} 2069 \\ 1563 \\ \hline 506 \end{array}$$

$$\begin{array}{r} 2069 \\ 1563 \\ \hline 506 \end{array}$$

$$\begin{array}{r} 2774 \\ 2326 \\ \hline 448 \end{array}$$

$$\begin{array}{r} 2326 \\ 2069 \\ \hline 257 \end{array}$$

$$\begin{array}{r} 2774 \\ 1452 \\ \hline 1322 \end{array}$$
15-127-60071
Morris

KANSAS ✓

Section 17 Township 14 Range 7EWell No. #1 AndersonCompany Continental Oil Company