

Morris

KANSAS

Sec. 16 Twp. 14 R. 8 E ✓

Well No. # 1 Zahnley Farm

Woods Oil & Gas Company

Woods Contractor


Wildcat

Ft. from N. Line

330 Ft. from S. Line

330 Ft. from E. Line

Ft. from W. Line

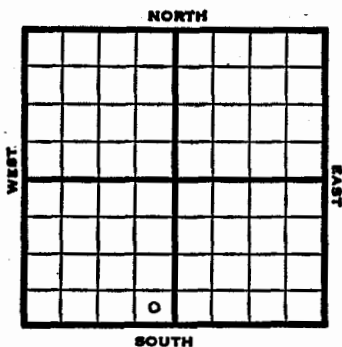

SE SE SW
Carter-acreage & DHM

1951 Elev. 1532' REPORT

9/5 R U R

9/19 D & A TD 2062' 8" ● 170
 Heeb 1200' Lans. 1420' KC 1524'
 B KC 1727' Cherokee 1889' Decora
 1897' SSO 1903-07', 1907-11'
 DST 1902-11' open 2 hr. rec 305' SW
 St. Peter 1926' Arb. 2012'
 TD 2062' D & A

ABANDONED

KANSAS

Section 16 Township 14 Range 8E

Well No. #1 Zahnley

Company Woods Oil & Gas

