

County <u>Dickinson</u> Elev. _____				Co.
Sec. <u>2</u> Twp. <u>15</u> Rgs. <u>1E</u>				
Company <u>Don Ingling</u>				
FarmName <u>Robson</u> No. <u>1</u>				
TOPS	DEPTH	LOG	DATUM	Loc. in Sec.
Anh.				SW SE SW
Tr.				
H.				
Tr.				
Dg.				
BL.				
L.				Geol. _____
K.C.				Contr. _____
B.K.C.				Co. tools
Ce.				
C.				Pool
M.				Wildcat
M.				
K.				
Mz.				
Ma.				
V.				
S.				
A.				
R.				
Pe.				
G.				
TD.				

Date Comm. 6-20-55

8" @ 95/60 WCC

FIRST REPORT
JUN 22 1955

County <u>Dickinson</u> Elev. <u>1213</u>				Co.
Sec. <u>2</u> Twp. <u>15</u> Rgs. <u>1E</u>				
Company <u>Don Ingling</u>				
FarmName <u>Robson</u> No. <u>1</u>				
TOPS	DEPTH	LOG	DATUM	Loc. in Sec.
Anh.				SW SE SW
Tr.				
H.				
Tr.				
Dg.				
BL.				
L.				Geol. _____
K.C.	<u>1777</u>		<u>564</u>	Contr. _____
B.K.C.				Co. tools
Ce.				
C.				Pool
M.	<u>2412</u>		<u>1199</u>	Wildcat
M.				
K.	<u>2602</u>		<u>1389</u>	
Mz. <u>Hunter</u>	<u>2758</u>		<u>1545</u>	
Ma.	<u>2930</u>		<u>1717</u>	
V.	<u>3025</u>		<u>1812</u>	
S.				
A.				
R.				
Pe.				
G.				
TD.	<u>3048</u>			

Date Comm. 6-20-55

8" @ 95/60 5 1/2" @ 2503 CO to 2450

20/ 2439-41 SSO & Wtr. 500 A

S/ 2 bwph PB 2434 16/ 2413-17

16/ 2422-26 S/ 5 bo 5 bw 8 hr.

frac HFW

D & A

ABANDONED
JUL 20 1955

Dickinson KANSAS
 SEC. 2 TWP. 15 R. 1E

WELL NO. 1 Robson FARM

COMPANY Don Ingling

CONTRACTOR Co Tools

Wildcat


Ft. from N. Line

Ft. from S. Line

Ft. from E. Line

Ft. from W. Line

SW SE SW

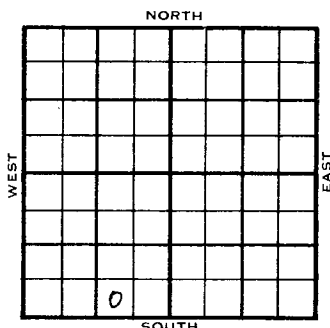

1955 ELEVATION 1213' REPORT

6/22 Comm 6-20-55
 8" @ 95/60
 WOC

7/20 Comm 6-20-55
 KC 1777
 M 2412
 K 2602
 Mz. Hunton 2758
 Mq 2930
 V 3025
 TD 3048
 8" @ 95/60 5 1/2" @ 2503 GO to
 2450 20/2439-41 SSO & wtr
 500 A S/2 bwph PB 2434 16/2413-17
 16/2422-26 S/5 bo 5 bw 8 hr
 ffac HFW
 D & A

ABANDONED

DX-78

15-041-00043

DX 78-1

Dickinson KANSAS

Section 2 Township 15 Range 1 E

Well No. #1 Robson

Company Don Ingling

