

Drlg. Data Ashgrove Pool
8" @ 100 drlg. 1617

FABEN GILSTRAD

Orig. Data			
8" @ 100	Lans. 1899	Miss. 2553	TD 2576
D & A			

FABEN GILSTRAP

Dickinson KANSAS

SEC.	TWP.	R.
5	15	1E

WELL NO.

1 Bourbina

FARM

COMPANY

Loren W. Hallam et al

CONTRACTOR

Ingling

Ashgrove Pool

Ft. from N. Line

330


Ft. from S. Line

Ft. from E. Line

330

Ft. from W. Line

SW SWNE

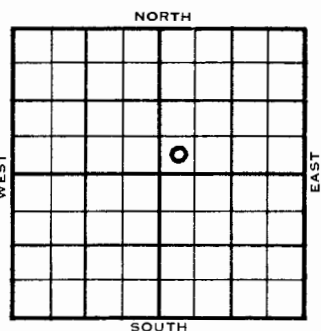

	ELEVATION	REPORT
1954		
8-25	Spdg 8-18-54 8" @ 100 Drlg. 1617	
9/1	Spud 8-18-54 8" @ 100 Lans. 1899 Miss 2553 TD 2576 D & A	
	ABANDONED	

DX-78

Dickinson

DX 78-1

15-041-00027

KANSAS

Section 5 Township 15 Range 1E

Well No. #1 Bourbina

Company Loren W. Hallam et al

