



Dickinson KANSAS

Dickinson KANSAS

DX 78-1

SEC. 5 TWP. 15 R. 1E

WELL NO. 1 A. Wilson FARM

COMPANY D. T. Ingling et al

CONTRACTOR Ingling Wildcat

Section 5 Township 15 Range 1E

Well No. 1 A. Wilson


Company D. T. Ingling et al

Ft. from N. Line \_\_\_\_\_

330 Ft. from S. Line \_\_\_\_\_

Ft. from E. Line \_\_\_\_\_

330 Ft. from W. Line \_\_\_\_\_

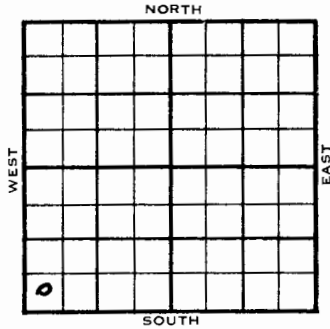

SW SW SW

	ELEVATION	REPORT
1954	1302	
7/7		Spudding 7-2-54 8" @ 105 Drlg. 1605
9/1		Spud 7-2-54 Oil well TD 2579 8" @ 105 Br. lime 1887 KC 1935 Cherokee 2269 Burgess 2558 Miss 2569 DST 2569-77, failed. TD 2579 4" @ 2571 CO to 2579 B/2 BOPH 4 hr. Comp. 25 BOPD
		<b>COMPLETED</b>

