

County Dickinson State Kansas
 Sec. 5 (Bk. 15) (Sur. 1E) Map No.

Operator D. T. Ingling

Well No. 1 Farm M. Bourbina

Elev. _____ Location SW SW SE

330ft. From S Line SE

330ft. From W Line Quarter

1st. Report MAY 25 1955

Completion _____

Remarks _____

Spudding Date 5-21-55

Drilg. Data Ash Grove Pool

8" @ 100 drlg. 420

FORM 513 REV. SUNRAY

County Dickinson Elev. 1279

Sec. 5 Twp. 15 Rge. 1E

Company D. T. Ingling

Farm Name M. Bourbina No. 1

Loc. in Sec. SW SWSE

Geol. _____

Contr. _____

Pool _____

Ash Grove

Dickinson **KANSAS**

SEC.	TWP.	R.
5	15	1E

WELL NO.
1 M. Bourbina FARM

COMPANY
D. T. Ingling

CONTRACTOR

Ash Grove Pool


_____ Ft. from N. Line

330' _____ Ft. from S. Line

_____ Ft. from E. Line

330' _____ Ft. from W. Line

SW SW SE

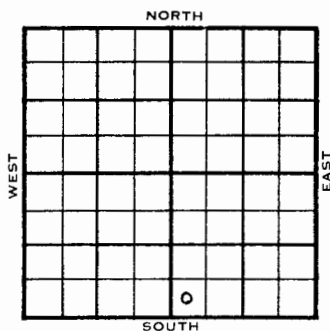

	ELEVATION	REPORT
1955	1279'	
5/25		Spud 5-21-55 8" @ 100 Drlg 420'
7/13		Comm. 5-21-55 8" @ 100/60 5 1/2" @ 2541 DD 2555' S/2 1/2 BOPH 6 hr. 1000 A. Comp. 20 BOPD 15 BW Burg. 2538', M. 2540' TD 2542'
		COMPLETED

DX-78

15-041-00068

DX 78-1 **Dickinson** **KANSAS**

Section 5 Township 15 Range 1E

Well No. #1 M. Bourbina

Company D. T. Ingling

