

Dickinson
Map No. 25 Sec. 6 Twp. 15 R. 1EWell No. 6 Strat Test

Carter


Company

FIRST REPORTand
ABANDONED

Contractor

SW/C

SECTION PLAT

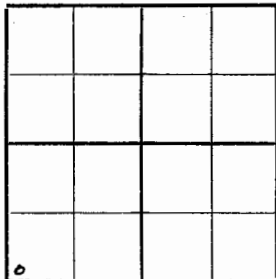

_____ Ft. from N. Line

330 Ft. from S. Line

_____ Ft. from E. Line

330 Ft. from W. Line

WILDCAT

Location _____

Rig up _____

Drilling and Remarks:

Flo 470'

Wreford 550'

Lansing 1955'

Marmation 2330'

Cherokee 2480'

Mississippi 2590'

Show of oil 2613'-20'

Kinderhook 2805'

Hunton 2953'

Viola 3230'

Simpson 3340'

Arbuckle 3395'

Date

RECORD

Cased _____ in., _____ ft.

Sand _____

Gas _____

Oil _____

Total Depth 3450

PRODUCTION

1st 24 hrs. Nat. _____

1st 24 hrs. after shot _____

Gas _____ Cu. Ft.

Dry Hole _____

Abandoned _____

APR 22 1942

19

S. J. LEWIS

Scout

*This is the stratigraphic
hole that they
drilled the day before
this.*

*This is in the SW 1/4
the day hole is SW 1/4 SW*

Sandy

KANSAS

Dickinson

Sec. 6 Twp. 15 R. 1-E

Well No. #6 Strat. Test Farm
Carter Company


(Wildcat)

Ft. from N. Line

330 Ft. from S. Line

Ft. from E. Line

330 Ft. from W. Line

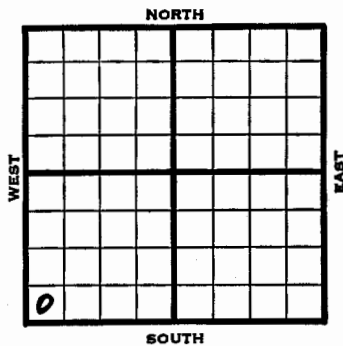

1942 E1 1323 REPORT

4/22	Flo 470'	
	Wreford 550'	<u>2830</u> <u>1323</u>
	Lansing 1955'	<u>1007</u>
	Marmation 2330'	
	Cherokee 2480'	<u>2590</u> <u>2330</u> <u>260</u>
	Mississippi 2590'	
	Show of oil 2613'	
	Kinderhook 2805'	
	Hunton 2953'	
	Viola 3230'	<u>3340</u> <u>2953</u> <u>387</u>
	Simpson 3340'	
	Arbuckle 3395'	
	T.D. 3450'	

FIRST REPORT

and
ABANDONED

KANSAS 15-041-20057

Dickinson

Section 6 Township 15 Range 1-E

Well No. #6 Strat Test

Company Carter

