

Dickinson KANSAS

SEC. 6 TWP. 15 R. 1E


WELL NO. #2 Riordan FARM

COMPANY D.T. Ingling.

CONTRACTOR Co. Tools.

Ash Grove Pool

_____ Ft. from N. Line
 990 _____ Ft. from S. Line
 330 _____ Ft. from E. Line
 _____ Ft. from W. Line

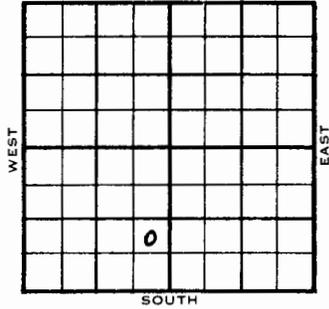

NE SE SW

1955	ELEVATION	REPORT
	1308'	

3/2	Spud 2-22-55 8" @ 100' Drlg. 1163'
3/30	Spud 2-22-55 Oil Well TD 2587' 8" @ 100' Br. Lime. 1890' Lans. 1930' Burg. 2574' Miss 2575' TD 2580' 4 1/2" @ 2578' DD 2587 1500 A 6 boph Comp 61 bopd.

COMPLETED

DX 78-1

Dickinson KANSAS

Section 6 Township 15 Range 1E

Well No. 2 Riordan

Company D. T. Ingling

