


Dickinson KANSAS

DX 78-1
 SEC. 6 TWP. 15 R. 1 E
 WELL NO. # 1 Riordan FARM
 COMPANY
 CONTRACTOR D. T. Ingling

Co. tools
 Ash Grove Pool

_____ Ft. from N. Line
 330 _____ Ft. from S. Line
 330 _____ Ft. from E. Line
 _____ Ft. from W. Line
 SE SE SW

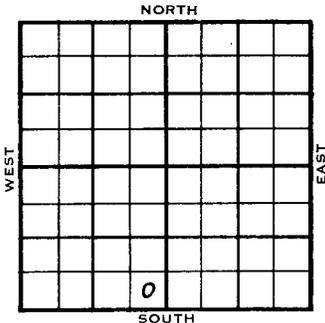

	ELEVATION	REPORT
1955	1319'	
1/5		Spud 12-30-54 8" @ 100 Drlg. 1410'
2/9		Spud 12-30-54 Oil Well TD 2602' 8" @ 100' Br. Lime 1903' Lans 1946' Burgess 2582' Miss 2587' DST 2582'-88' opn 45 min, rec 33' Mud 820# TD 2602' 4" @ 2590' S/ 3 boph 4 hr. 500 A S/ 8 boph 3 hr. Comp 54 bopd.
		COMPLETED

15-041-00070

DX 78-1 Dickinson KANSAS
 Section 6 Township 15 Range 1E
 Well No. 1 Riordan
 Company D. T. Ingling

