

Dickinson

KANSAS

SEC. 6 TWP. 15 R. 1E
 WELL NO. #3 N. Hall FARM
 COMPANY D.T. Ingling
 CONTRACTOR

Co. Tools.

Ash Grove Pool NORTH

Ft. from N. Line


990

Ft. from S. Line

Ft. from E. Line

330

Ft. from W. Line

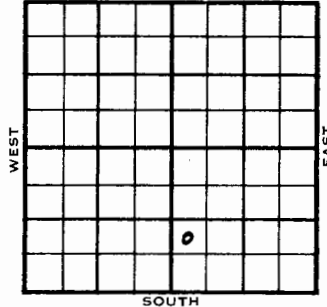

NW SW SE

	ELEVATION	REPORT
1955	1323'	

3/9 M I R

4/13

Spud 3-8-55 Temp. abd. TD 2631
 8" @ 103 Br. lime 1905, Lans 1945'
 Miss 2595 TD 2612 4" @ 2602
 CO to 2612 1000 A FU 1600' wtr.
 DD 2617 S/acid wtr. DD 2631' HFW
 Temp. abd.

ABANDONED

DX-78

DX 78-1

Dickinson KANSAS

Section 6 Township 15 Range 1E
 Well No. 3 N. Hall
 Company D. T. Ingling

