



Dickinson

KANSAS


SEC.	TWP.	R.
6	15	1E

WELL NO. #2 Hall FARM

COMPANY D. T. Ingling.

CONTRACTOR Co. Tools.

Ash Grove Reel

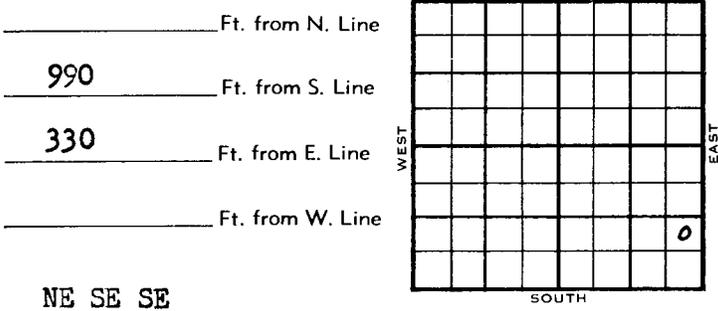

	ELEVATION	REPORT
1954	1317'	
12/22	Spud 12-19-54 8" @ 100' Drlg. 790'	
1955 1/26	Spud 12-19-54 - Oil Well TD 2592' 8" @ 100' Burgess 2578', Miss. 2581' TD 2588' 4 1/2" @ 2586' CO to 2588', 100A FU 250' oil 12 hrs. DD 2592' B 2/3 boph 1500A S/3 boph B r. line 1906', L ans. 1948' P/25 bopd Comp. 39 bopd 12% wtr.	
<b>COMPLETED</b>		

DX-78

Dickinson

KANSAS

DX 78-1

Section 6 Township 15 Range 1E

Well No. #2 Hall

Company D.T. Ingling.

